

FROM:

Wallace C. Drennan, Inc.
Post Office Box 15438
New Orleans, LA 70175-5438

LOUISIANA CONTRACTOR'S LICENSE NO.: **1033**

SEALED BID TO:

Jefferson Parish
General Government Building
ATTN: Purchasing Department
200 Derbigny Street, Suite 4400
Gretna, LA 70053

SEALED BID FOR:

River Road Water Line Replacement
Rivet Blvd. to Willswood Lane
Project No. 2015-049-WR
Proposal No. 50-00117630

LOUISIANA UNIFORM PUBLIC WORK BID FORM

TO: Jefferson Parish Purchasing Department
200 Derbigny Street, Suite 4400
Gretna, Louisiana 70053
ATTN: Purchasing
(Owner to provide name and address of owner)

BID FOR: River Road Waterline Replacement – Phase 2
Willswood Lane to Rivet Blvd.
Public Works Project No. 2015-049-WR
Bid Proposal No. 50-00117630
(Owner to provide name of project and other identifying information)

The undersigned bidder hereby declares and represents that she/he; a) has carefully examined and understands the Bidding Documents, b) has not received, relied on, or based his bid on any verbal instructions contrary to the Bidding Documents or any addenda, c) has personally inspected and is familiar with the project site, and hereby proposes to provide all labor, materials, tools, appliances and facilities as required to perform, in a workmanlike manner, all work and services for the construction and completion of the referenced project, all in strict accordance with the Bidding Documents prepared by: _____

Digital Engineering and dated: 8/01/2016
(Owner to provide name of entity preparing bidding documents.)

Bidders must acknowledge all addenda. The Bidder acknowledges receipt of the following **ADDENDA:** (Enter the number the Designer has assigned to each of the addenda that the Bidder is acknowledging) #1, 9/29/16 #2, 10/03/16 #3, 10/10/16 .

#4, 10/11/16
TOTAL BASE BID: For all work required by the Bidding Documents (including any and all unit prices designated "Base Bid" * but not alternates) the sum of:

One Million Eight Hundred Eighteen Thousand Nine Hundred Eighty Six _____ Dollars (\$ 1,818,986.00)
and no cents

ALTERNATES: For any and all work required by the Bidding Documents for Alternates including any and all unit prices designated as alternates in the unit price description.

Alternate No. 1 *(Owner to provide description of alternate and state whether add or deduct)* for the lump sum of:

N/A Dollars (\$ _____)

Alternate No. 2 *(Owner to provide description of alternate and state whether add or deduct)* for the lump sum of:

N/A Dollars (\$ _____)

Alternate No. 3 *(Owner to provide description of alternate and state whether add or deduct)* for the lump sum of:

N/A Dollars (\$ _____)

NAME OF BIDDER: Wallace C. Drennan, Inc.

ADDRESS OF BIDDER: P.O. Box 15438

New Orleans, LA 70175-5438

LOUISIANA CONTRACTOR'S LICENSE NUMBER: # 1033

NAME OF AUTHORIZED SIGNATORY OF BIDDER: Wallace C. Drennan, III

TITLE OF AUTHORIZED SIGNATORY OF BIDDER: President

SIGNATURE OF AUTHORIZED SIGNATORY OF BIDDER **: Wallace C. Drennan, III

DATE: October 25, 2016

* The Unit Price Form shall be used if the contract includes unit prices. Otherwise it is not required and need not be included with the form. The number of unit prices that may be included is not limited and additional sheets may be included if needed.

** If someone other than a corporate officer signs for the Bidder/Contractor, a copy of a corporate resolution or other signature authorization shall be required for submission of bid. Failure to include a copy of the appropriate signature authorization, if required, may result in the rejection of the bid unless bidder has complied with La. R.S. 38:2212(B)5.

BID SECURITY in the form of a bid bond, certified check or cashier's check as prescribed by LA RS 38:2218.A is attached to and made a part of this bid.

LOUISIANA UNIFORM PUBLIC WORK BID FORM

UNIT PRICE FORM

TO: Jefferson Parish Purchasing Department
 200 Derbigny Street, Suite 4400
 Gretna, Louisiana 70053
 ATTN: Purchasing
 (Owner to provide name and address of owner)

BID FOR: River Road Waterline Replacement – Phase 2
 Willwood Lane to Rivet Blvd.
 Public Works Project No. 2015-049-WR
 Bid Proposal No. 50-00117630
 (Owner to provide name of project and other identifying information)

UNIT PRICES: This form shall be used for any and all work required by the Bidding Documents and described as unit prices. Amounts shall be stated in figures and only in figures.

DESCRIPTION:	REMOVAL OF STRUCTURES AND OBSTRUCTIONS	<input checked="" type="checkbox"/> Base Bid or <input type="checkbox"/> Alt.#	UNIT PRICE	UNIT PRICE EXTENSION (Quantity times Unit Price)
REF. NO.	QUANTITY:	UNIT OF MEASURE:		
202-02-00100	1	Lump Sum	\$45,000.00	\$45,000.00

DESCRIPTION:	REMOVE AND REPLACE CONCRETE BOLLARDS	<input checked="" type="checkbox"/> Base Bid or <input type="checkbox"/> Alt.#	UNIT PRICE	UNIT PRICE EXTENSION (Quantity times Unit Price)
REF. NO.	QUANTITY:	UNIT OF MEASURE:		
S-001	8	Each	\$ 300.00	\$ 2,400.00

DESCRIPTION:	REMOVAL OF CONCRETE DRIVES	<input checked="" type="checkbox"/> Base Bid or <input type="checkbox"/> Alt.#	UNIT PRICE	UNIT PRICE EXTENSION (Quantity times Unit Price)
REF. NO.	QUANTITY:	UNIT OF MEASURE:		
202-02-06100	900	Sq. Yd.	\$ 1.00	\$ 900.00

DESCRIPTION:	REMOVE AND REPLACE WOODEN BOLLARDS	<input checked="" type="checkbox"/> Base Bid or <input type="checkbox"/> Alt.#	UNIT PRICE	UNIT PRICE EXTENSION (Quantity times Unit Price)
REF. NO.	QUANTITY:	UNIT OF MEASURE:		
S-004	120	Each	\$ 50.00	\$ 6,000.00

DESCRIPTION:	TEMPORARY EROSION CONTROL	<input checked="" type="checkbox"/> Base Bid or <input type="checkbox"/> Alt.#	UNIT PRICE	UNIT PRICE EXTENSION (Quantity times Unit Price)
REF. NO.	QUANTITY:	UNIT OF MEASURE:		
204-01-10000	1	Lump	\$ 101.00	\$ 101.00

DESCRIPTION:	TRAFFIC MAINTENANCE AGGREGATE	<input checked="" type="checkbox"/> Base Bid or <input type="checkbox"/> Alt.#	UNIT PRICE	UNIT PRICE EXTENSION (Quantity times Unit Price)
REF. NO.	QUANTITY:	UNIT OF MEASURE:		
402-01-00100	180	Cu Yd.	\$ 1.00	\$ 180.00

DESCRIPTION:	24" RCP NEW DRIVEWAY PIPE	<input checked="" type="checkbox"/> Base Bid or <input type="checkbox"/> Alt.#	UNIT PRICE	UNIT PRICE EXTENSION (Quantity times Unit Price)
REF. NO.	QUANTITY:	UNIT OF MEASURE:		
701-03-00100	4	Each	\$ 2,500.00	\$ 10,000.00

All quantities are estimated. The contractor will be paid based upon actual quantities as verified by the Owner

LOUISIANA UNIFORM PUBLIC WORK BID FORM

UNIT PRICE FORM

TO: Jefferson Parish Purchasing Department
 200 Derbigny Street, Suite 4400
 Gretna, Louisiana 70053
 ATTN: Purchasing
 (Owner to provide name and address of owner)

BID FOR: River Road Waterline Replacement – Phase 2
 Willswood Lane to Rivet Blvd.
 Public Works Project No. 2015-049-WR
 Bid Proposal No. 50-00117630
 (Owner to provide name of project and other identifying information)

UNIT PRICES: This form shall be used for any and all work required by the Bidding Documents and described as unit prices. Amounts shall be stated in figures and only in figures.

DESCRIPTION:	CONCRETE DRIVE (6" THICK) <input checked="" type="checkbox"/> Base Bid or <input type="checkbox"/> Alt.#	UNIT PRICE	UNIT PRICE EXTENSION (Quantity times Unit Price)
REF. NO.	QUANTITY: UNIT OF MEASURE:		
706-02-00200	900 Sq. Yd.	\$ 85.00	\$ 76,500.00

DESCRIPTION:	SLAB SODDING (ST. AUGUSTINE) <input checked="" type="checkbox"/> Base Bid or <input type="checkbox"/> Alt.#	UNIT PRICE	UNIT PRICE EXTENSION (Quantity times Unit Price)
REF. NO.	QUANTITY: UNIT OF MEASURE:		
714-01-00600	2,600 Sq. Yd.	\$ 3.00	\$ 7,800.00

DESCRIPTION:	SEEDING <input checked="" type="checkbox"/> Base Bid or <input type="checkbox"/> Alt.#	UNIT PRICE	UNIT PRICE EXTENSION (Quantity times Unit Price)
REF. NO.	QUANTITY: UNIT OF MEASURE:		
717-01-00100	80 Lbs.	\$ 15.00	\$ 1,200.00

DESCRIPTION:	MOBILIZATION <input checked="" type="checkbox"/> Base Bid or <input type="checkbox"/> Alt.#	UNIT PRICE	UNIT PRICE EXTENSION (Quantity times Unit Price)
REF. NO.	QUANTITY: UNIT OF MEASURE:		
727-01-00100	1 Lump	\$ 85,000.00	\$ 85,000.00

DESCRIPTION:	ADJUSTING WATER METER BOX <input checked="" type="checkbox"/> Base Bid or <input type="checkbox"/> Alt.#	UNIT PRICE	UNIT PRICE EXTENSION (Quantity times Unit Price)
REF. NO.	QUANTITY: UNIT OF MEASURE:		
741-11-00200	30 Each	\$ 10.00	\$ 300.00

DESCRIPTION:	MAINTENANCE OF TRAFFIC, SIGNS AND BARRICADES <input checked="" type="checkbox"/> Base Bid or <input type="checkbox"/> Alt.#	UNIT PRICE	UNIT PRICE EXTENSION (Quantity times Unit Price)
REF. NO.	QUANTITY: UNIT OF MEASURE:		
NS-MNT-20032	1 Lump	\$ 40,000.00	\$ 40,000.00

DESCRIPTION:	EXPLORATORY EXCAVATION <input checked="" type="checkbox"/> Base Bid or <input type="checkbox"/> Alt.#	UNIT PRICE	UNIT PRICE EXTENSION (Quantity times Unit Price)
REF. NO.	QUANTITY: UNIT OF MEASURE:		
S-002	40 Each	\$ 100.00	\$ 4,000.00

All quantities are estimated. The contractor will be paid based upon actual quantities as verified by the Owner

LOUISIANA UNIFORM PUBLIC WORK BID FORM

UNIT PRICE FORM

TO: Jefferson Parish Purchasing Department
 200 Derbigny Street, Suite 4400
 Gretna, Louisiana 70053
 ATTN: Purchasing
 (Owner to provide name and address of owner)

BID FOR: River Road Waterline Replacement – Phase 2
 Willswood Lane to Rivet Blvd.
 Public Works Project No. 2015-049-WR
 Bid Proposal No. 50-00117630
 (Owner to provide name of project and other identifying information)

UNIT PRICES: This form shall be used for any and all work required by the Bidding Documents and described as unit prices. Amounts shall be stated in figures and only in figures.

DESCRIPTION:	TEMPORARY DRIVEWAY RAMP <input checked="" type="checkbox"/> Base Bid or <input type="checkbox"/> Alt.#	UNIT PRICE	UNIT PRICE EXTENSION (Quantity times Unit Price)
REF. NO.	QUANTITY:	UNIT OF MEASURE:	
S-003	30	Each	\$ 100.00
			\$ 3,000.00

DESCRIPTION:	ASPHALT PATCHING <input checked="" type="checkbox"/> Base Bid or <input type="checkbox"/> Alt.#	UNIT PRICE	UNIT PRICE EXTENSION (Quantity times Unit Price)
REF. NO.	QUANTITY:	UNIT OF MEASURE:	
510-01-00100	360	Sq. Yd.	\$ 200.00
			\$ 72,000.00

DESCRIPTION:	GRIND EXISTING STUMPS <input checked="" type="checkbox"/> Base Bid or <input type="checkbox"/> Alt.#	UNIT PRICE	UNIT PRICE EXTENSION (Quantity times Unit Price)
REF. NO.	QUANTITY:	UNIT OF MEASURE:	
S-005	2	Each	\$ 500.00
			\$ 1,000.00

DESCRIPTION:	PROJECT SIGN <input checked="" type="checkbox"/> Base Bid or <input type="checkbox"/> Alt.#	UNIT PRICE	UNIT PRICE EXTENSION (Quantity times Unit Price)
REF. NO.	QUANTITY:	UNIT OF MEASURE:	
S-006	2	Each	\$ 5,000.00
			\$ 10,000.00

DESCRIPTION:	REMOVE AND REPLACE GRAVEL DRIVES <input checked="" type="checkbox"/> Base Bid or <input type="checkbox"/> Alt.#	UNIT PRICE	UNIT PRICE EXTENSION (Quantity times Unit Price)
REF. NO.	QUANTITY:	UNIT OF MEASURE:	
S-007	325	Sq. Yd.	\$ 1.00
			\$ 325.00

DESCRIPTION:	REMOVAL OF FIRE HYDRANTS <input checked="" type="checkbox"/> Base Bid or <input type="checkbox"/> Alt.#	UNIT PRICE	UNIT PRICE EXTENSION (Quantity times Unit Price)
REF. NO.	QUANTITY:	UNIT OF MEASURE:	
S-009	11	Each	\$ 500.00
			\$ 5,500.00

DESCRIPTION:	FENCE ANY KIND <input checked="" type="checkbox"/> Base Bid or <input type="checkbox"/> Alt.#	UNIT PRICE	UNIT PRICE EXTENSION (Quantity times Unit Price)
REF. NO.	QUANTITY:	UNIT OF MEASURE:	
S-010	500	Lin. Ft.	\$ 15.00
			\$ 7,500.00

DESCRIPTION:	WATER MAIN (6") (PVC C900) <input checked="" type="checkbox"/> Base Bid or <input type="checkbox"/> Alt.#	UNIT PRICE	UNIT PRICE EXTENSION (Quantity times Unit Price)
REF. NO.	QUANTITY:	UNIT OF MEASURE:	
W-106	20	Lin. Ft.	\$ 20.00
			\$ 400.00

All quantities are estimated. The contractor will be paid based upon actual quantities as verified by the Owner

LOUISIANA UNIFORM PUBLIC WORK BID FORM

UNIT PRICE FORM

TO: Jefferson Parish Purchasing Department
 200 Derbigny Street, Suite 4400
 Gretna, Louisiana 70053
 ATTN: Purchasing
 (Owner to provide name and address of owner)

BID FOR: River Road Waterline Replacement – Phase 2
 Willswood Lane to Rivet Blvd.
 Public Works Project No. 2015-049-WR
 Bid Proposal No. 50-00117630
 (Owner to provide name of project and other identifying information)

UNIT PRICES: This form shall be used for any and all work required by the Bidding Documents and described as unit prices. Amounts shall be stated in figures and only in figures.

DESCRIPTION:	WATER MAIN (8") (PVC C900) <input checked="" type="checkbox"/> Base Bid or <input type="checkbox"/> Alt.#		UNIT PRICE	UNIT PRICE EXTENSION (Quantity times Unit Price)
REF. NO.	QUANTITY:	UNIT OF MEASURE:		
W-108	200	Lin. Ft.	\$ 30.00	\$ 6,000.00
DESCRIPTION:	WATER MAIN (12") (PVC C900) <input checked="" type="checkbox"/> Base Bid or <input type="checkbox"/> Alt.#		UNIT PRICE	UNIT PRICE EXTENSION (Quantity times Unit Price)
REF. NO.	QUANTITY:	UNIT OF MEASURE:		
W-112	12,910	Lin. Ft.	\$ 70.00	\$ 903,700.00
DESCRIPTION:	WATER MAIN (6") (DUCTILE IRON PIPE) <input checked="" type="checkbox"/> Base Bid or <input type="checkbox"/> Alt.#		UNIT PRICE	UNIT PRICE EXTENSION (Quantity times Unit Price)
REF. NO.	QUANTITY:	UNIT OF MEASURE:		
W-206	100	Lin. Ft.	\$ 30.00	\$ 3,000.00
DESCRIPTION:	WATER MAIN (8") (DUCTILE IRON PIPE) <input checked="" type="checkbox"/> Base Bid or <input type="checkbox"/> Alt.#		UNIT PRICE	UNIT PRICE EXTENSION (Quantity times Unit Price)
REF. NO.	QUANTITY:	UNIT OF MEASURE:		
W-208	100	Lin. Ft.	\$ 40.00	\$ 4,000.00
DESCRIPTION:	WATER MAIN (12") (DUCTILE IRON PIPE) <input checked="" type="checkbox"/> Base Bid or <input type="checkbox"/> Alt.#		UNIT PRICE	UNIT PRICE EXTENSION (Quantity times Unit Price)
REF. NO.	QUANTITY:	UNIT OF MEASURE:		
W-212	100	Lin. Ft.	\$ 80.00	\$ 8,000.00
DESCRIPTION:	GATE VALVE AND VALVE BOX (6") <input checked="" type="checkbox"/> Base Bid or <input type="checkbox"/> Alt.#		UNIT PRICE	UNIT PRICE EXTENSION (Quantity times Unit Price)
REF. NO.	QUANTITY:	UNIT OF MEASURE:		
W-406	1	Each	\$ 1,000.00	\$ 1,000.00
DESCRIPTION:	GATE VALVE AND VALVE BOX (8") <input checked="" type="checkbox"/> Base Bid or <input type="checkbox"/> Alt.#		UNIT PRICE	UNIT PRICE EXTENSION (Quantity times Unit Price)
REF. NO.	QUANTITY:	UNIT OF MEASURE:		
W-408	12	Each	\$ 1,500.00	\$ 18,000.00
DESCRIPTION:	GATE VALVE AND VALVE BOX (12") <input checked="" type="checkbox"/> Base Bid or <input type="checkbox"/> Alt.#		UNIT PRICE	UNIT PRICE EXTENSION (Quantity times Unit Price)
REF. NO.	QUANTITY:	UNIT OF MEASURE:		
W-412	46	Each	\$ 2,200.00	\$ 101,200.00

All quantities are estimated. The contractor will be paid based upon actual quantities as verified by the Owner

LOUISIANA UNIFORM PUBLIC WORK BID FORM

UNIT PRICE FORM

TO: Jefferson Parish Purchasing Department
 200 Derbigny Street, Suite 4400
 Gretna, Louisiana 70053
 ATTN: Purchasing
 (Owner to provide name and address of owner)

BID FOR: River Road Waterline Replacement – Phase 2
 Willswood Lane to Rivet Blvd.
 Public Works Project No. 2015-049-WR
 Bid Proposal No. 50-00117630
 (Owner to provide name of project and other identifying information)

UNIT PRICES: This form shall be used for any and all work required by the Bidding Documents and described as unit prices. Amounts shall be stated in figures and only in figures.

DESCRIPTION:	PIPE RESERTAINT (6") <input type="checkbox"/> Base Bid or <input type="checkbox"/> Alt.#	UNIT PRICE	UNIT PRICE EXTENSION (Quantity times Unit Price)
REF. NO.	QUANTITY:	UNIT OF MEASURE:	
W-706	2	Each	\$ 30.00 \$ 60.00

DESCRIPTION:	PIPE RESERTAINT (8") <input type="checkbox"/> Base Bid or <input type="checkbox"/> Alt.#	UNIT PRICE	UNIT PRICE EXTENSION (Quantity times Unit Price)
REF. NO.	QUANTITY:	UNIT OF MEASURE:	
W-708	22	Each	\$ 40.00 \$ 880.00

DESCRIPTION:	PIPE RESERTAINT (12") <input type="checkbox"/> Base Bid or <input type="checkbox"/> Alt.#	UNIT PRICE	UNIT PRICE EXTENSION (Quantity times Unit Price)
REF. NO.	QUANTITY:	UNIT OF MEASURE:	
W-712	100	Each	\$ 477.00 \$ 47,700.00

DESCRIPTION:	TRANSITIONAL COUPLING (6") <input type="checkbox"/> Base Bid or <input type="checkbox"/> Alt.#	UNIT PRICE	UNIT PRICE EXTENSION (Quantity times Unit Price)
REF. NO.	QUANTITY:	UNIT OF MEASURE:	
W-806	1	Each	\$ 550.00 \$ 550.00

DESCRIPTION:	TRANSITIONAL COUPLING (8") <input type="checkbox"/> Base Bid or <input type="checkbox"/> Alt.#	UNIT PRICE	UNIT PRICE EXTENSION (Quantity times Unit Price)
REF. NO.	QUANTITY:	UNIT OF MEASURE:	
W-807	13	Each	\$ 770.00 \$ 10,010.00

DESCRIPTION:	TRANSITIONAL COUPLING (12") <input type="checkbox"/> Base Bid or <input type="checkbox"/> Alt.#	UNIT PRICE	UNIT PRICE EXTENSION (Quantity times Unit Price)
REF. NO.	QUANTITY:	UNIT OF MEASURE:	
W-810	3	Each	\$ 1,200.00 \$ 3,600.00

DESCRIPTION:	DUCTILE IRON FITTINGS <input type="checkbox"/> Base Bid or <input type="checkbox"/> Alt.#	UNIT PRICE	UNIT PRICE EXTENSION (Quantity times Unit Price)
REF. NO.	QUANTITY:	UNIT OF MEASURE:	
W-901	12,000	Lbs.	\$ 1.00 \$ 12,000.00

DESCRIPTION:	FIRE HYDRANT ASSEMBLY <input type="checkbox"/> Base Bid or <input type="checkbox"/> Alt.#	UNIT PRICE	UNIT PRICE EXTENSION (Quantity times Unit Price)
REF. NO.	QUANTITY:	UNIT OF MEASURE:	
W-902-A	27	Each	\$ 5,900.00 \$ 159,300.00

All quantities are estimated. The contractor will be paid based upon actual quantities as verified by the Owner

LOUISIANA UNIFORM PUBLIC WORK BID FORM

UNIT PRICE FORM

TO: Jefferson Parish Purchasing Department
 200 Derbigny Street, Suite 4400
 Gretna, Louisiana 70053
 ATTN: Purchasing
 (Owner to provide name and address of owner)

BID FOR: River Road Waterline Replacement – Phase 2
 Willswood Lane to Rivet Blvd.
 Public Works Project No. 2015-049-WR
 Bid Proposal No. 50-00117630
 (Owner to provide name of project and other identifying information)

UNIT PRICES: This form shall be used for any and all work required by the Bidding Documents and described as unit prices. Amounts shall be stated in figures and only in figures.

DESCRIPTION:	WATER SERVICE CONNECTION (<1")	<input type="checkbox"/> Base Bid or <input type="checkbox"/> Alt.#	UNIT PRICE	UNIT PRICE EXTENSION (Quantity times Unit Price)
REF. NO.	QUANTITY:	UNIT OF MEASURE:		
W-903-0	20	Each	\$ 100.00	\$ 2,000.00

DESCRIPTION:	WATER SERVICE CONNECTION (1")	<input type="checkbox"/> Base Bid or <input type="checkbox"/> Alt.#	UNIT PRICE	UNIT PRICE EXTENSION (Quantity times Unit Price)
REF. NO.	QUANTITY:	UNIT OF MEASURE:		
W-903-1	10	Each	\$ 866.00	\$ 8,660.00

DESCRIPTION:	WATER SERVICE CONNECTION (UP TO 2" POLYETHYLENE)	<input checked="" type="checkbox"/> Base Bid or <input type="checkbox"/> Alt.#	UNIT PRICE	UNIT PRICE EXTENSION (Quantity times Unit Price)
REF. NO.	QUANTITY:	UNIT OF MEASURE:		
W-903-2	10	Each	\$ 866.00	\$ 8,660.00

DESCRIPTION:	ABANDONMENT OF WATERLINE (8")	<input checked="" type="checkbox"/> Base Bid or <input type="checkbox"/> Alt.#	UNIT PRICE	UNIT PRICE EXTENSION (Quantity times Unit Price)
REF. NO.	QUANTITY:	UNIT OF MEASURE:		
W-908	12,910	Lin. Ft.	\$ 1.00	\$ 12,910.00

DESCRIPTION:	REMOVAL AND DISPOSAL OF AC WATERLINE (6")	<input checked="" type="checkbox"/> Base Bid or <input type="checkbox"/> Alt.#	UNIT PRICE	UNIT PRICE EXTENSION (Quantity times Unit Price)
REF. NO.	QUANTITY:	UNIT OF MEASURE:		
W-907-6	200	Lin. Ft.	\$ 1.00	\$ 200.00

DESCRIPTION:	REMOVAL AND DISPOSAL OF AC WATERLINE (8")	<input checked="" type="checkbox"/> Base Bid or <input type="checkbox"/> Alt.#	UNIT PRICE	UNIT PRICE EXTENSION (Quantity times Unit Price)
REF. NO.	QUANTITY:	UNIT OF MEASURE:		
W-907-8	200	Lin. Ft.	\$ 1.00	\$ 200.00

DESCRIPTION:	HANDICAPPED CURB RAMP	<input checked="" type="checkbox"/> Base Bid or <input type="checkbox"/> Alt.#	UNIT PRICE	UNIT PRICE EXTENSION (Quantity times Unit Price)
REF. NO.	QUANTITY:	UNIT OF MEASURE:		
706-04-00100	4	Each	\$ 1,500.00	\$ 6,000.00

DESCRIPTION:	18" RCP NEW DRIVEWAY PIPE	<input checked="" type="checkbox"/> Base Bid or <input type="checkbox"/> Alt.#	UNIT PRICE	UNIT PRICE EXTENSION (Quantity times Unit Price)
REF. NO.	QUANTITY:	UNIT OF MEASURE:		
701-03-00101	2	Each	\$ 100.00	\$ 200.00

All quantities are estimated. The contractor will be paid based upon actual quantities as verified by the Owner

LOUISIANA UNIFORM PUBLIC WORK BID FORM

UNIT PRICE FORM

TO: Jefferson Parish Purchasing Department
 200 Derbigny Street, Suite 4400
 Gretna, Louisiana 70053
 ATTN: Purchasing
 (Owner to provide name and address of owner)

BID FOR: River Road Waterline Replacement – Phase 2
 Willswood Lane to Rivet Blvd.
 Public Works Project No. 2015-049-WR
 Bid Proposal No. 50-00117630
 (Owner to provide name of project and other identifying information)

UNIT PRICES: This form shall be used for any and all work required by the Bidding Documents and described as unit prices. Amounts shall be stated in figures and only in figures.

DESCRIPTION:	REMOVAL OF PORTLAND CEMENT CONCRETE PAVEMENT	<input checked="" type="checkbox"/> Base Bid or <input type="checkbox"/> Alt.#	UNIT PRICE	UNIT PRICE EXTENSION (Quantity times Unit Price)
REF. NO.	QUANTITY:	UNIT OF MEASURE:		
202-02-02021	700	Sq. Yd.	\$ 1.00	\$ 700.00

DESCRIPTION:	REMOVE CONCRETE WALK	<input checked="" type="checkbox"/> Base Bid or <input type="checkbox"/> Alt.#	UNIT PRICE	UNIT PRICE EXTENSION (Quantity times Unit Price)
REF. NO.	QUANTITY:	UNIT OF MEASURE:		
202-02-06200	150	Sq. Yd.	\$ 1.00	\$ 150.00

DESCRIPTION:	PORTLAND CEMENT CONCRETE (9" THICK)	<input checked="" type="checkbox"/> Base Bid or <input type="checkbox"/> Alt.#	UNIT PRICE	UNIT PRICE EXTENSION (Quantity times Unit Price)
REF. NO.	QUANTITY:	UNIT OF MEASURE:		
601-01-00300	700	Sq. Yd.	\$ 125.00	\$ 87,500.00

DESCRIPTION:	CONCRETE WALK (4" THICK)	<input checked="" type="checkbox"/> Base Bid or <input type="checkbox"/> Alt.#	UNIT PRICE	UNIT PRICE EXTENSION (Quantity times Unit Price)
REF. NO.	QUANTITY:	UNIT OF MEASURE:		
706-01-00100	150	Sq. Yd.	\$ 50.00	\$ 7,500.00

DESCRIPTION:	REMOVE AND REPLACE CONCRETE CURB	<input checked="" type="checkbox"/> Base Bid or <input type="checkbox"/> Alt.#	UNIT PRICE	UNIT PRICE EXTENSION (Quantity times Unit Price)
REF. NO.	QUANTITY:	UNIT OF MEASURE:		
707-01-00100	500	Lin. Ft.	\$ 30.00	\$ 15,000.00

DESCRIPTION:	SUPERPAVE ASPHALTIC PAVEMENT	<input checked="" type="checkbox"/> Base Bid or <input type="checkbox"/> Alt.#	UNIT PRICE	UNIT PRICE EXTENSION (Quantity times Unit Price)
REF. NO.	QUANTITY:	UNIT OF MEASURE:		
502-01-00100	26	Ton	\$ 250.00	\$ 6,500.00

DESCRIPTION:	COLD PLANING ASPHALTIC CONCRETE PAVEMENT (2" THICK)	<input checked="" type="checkbox"/> Base Bid or <input type="checkbox"/> Alt.#	UNIT PRICE	UNIT PRICE EXTENSION (Quantity times Unit Price)
REF. NO.	QUANTITY:	UNIT OF MEASURE:		
509-01-00100	235	Sq. Yd.	\$ 20.00	\$ 4,700.00

All quantities are estimated. The contractor will be paid based upon actual quantities as verified by the Owner



Bond Number: SLA16987060

Contractor Information

Principal: Wallace C. Drennan, Inc.

Address: 1500 Nine Mile Point Westwego Louisiana 70094 United States

Owner/Obligee Information

Bond Form: Bid Bond in accordance with Contract Specifications

Owner/Obligee: Jefferson Parish

Address: 200 Derbigny Street Gretna Louisiana 70053 United States

Bond Information

Surety: The Hanover Insurance Co

Bid Date: 10/25/2016

Estimated Contract Price:

Time For Completion:

Liquidated Damages:

Estimated Work On Hand:

Amount of Bid Security: 5%

Contract # or IFB #: 50-00117630

Description of Job: River Road Water Line Replacement, Rivet Boulevard to Willswood Lane

Job Breakdown:

Electronic Bidding Information

Bid Security Percentage: 5

Bid Security Maximum:

Owner Assigned Contractor Number: BX268

Primary Agency:

Cory, Tucker & Larrowe, Inc

Power of Attorney Limited to: \$20,000,000

Executed

Entered By: Pamela K. Tucker - 10/11/2016 12:23:40 PM ET

Approved & Executed By:

Pamela K. Tucker

Pamela K. Tucker (Signed: 11-Oct-2016 12:24 PM EDT (UTC-04:00))

[Signature Information](#)

Know all men by these presents that The Hanover Insurance Co, a Corporation duly organized under the laws of the State of New Hampshire, are held and firmly bound unto the above owner/obligee by this transmission. The surety agrees to waive the Statute of Fraud defense and further agrees that the owner/obligee is a third party

beneficiary of the waiver for the purposes of enforcing this bid bond.

© S2000, Inc.

Document ID: [S2000-1000878755](#)



DRENNAN-02

LBARBER

CERTIFICATE OF LIABILITY INSURANCE

DATE (MM/DD/YYYY)

10/3/2016

THIS CERTIFICATE IS ISSUED AS A MATTER OF INFORMATION ONLY AND CONFERS NO RIGHTS UPON THE CERTIFICATE HOLDER. THIS CERTIFICATE DOES NOT AFFIRMATIVELY OR NEGATIVELY AMEND, EXTEND OR ALTER THE COVERAGE AFFORDED BY THE POLICIES BELOW. THIS CERTIFICATE OF INSURANCE DOES NOT CONSTITUTE A CONTRACT BETWEEN THE ISSUING INSURER(S), AUTHORIZED REPRESENTATIVE OR PRODUCER, AND THE CERTIFICATE HOLDER.

IMPORTANT: If the certificate holder is an ADDITIONAL INSURED, the policy(ies) must be endorsed. If SUBROGATION IS WAIVED, subject to the terms and conditions of the policy, certain policies may require an endorsement. A statement on this certificate does not confer rights to the certificate holder in lieu of such endorsement(s).

PRODUCER Cory, Tucker & Larowe, Inc. P. O. Box 6646 Metairie, LA 70009-6646	CONTACT NAME:	
	PHONE (A/C, No, Ext): (504) 834-5080 FAX (A/C, No): (504) 835-7726	
INSURED Wallace C. Drennan, Inc. 1500 Nine Mile Point Road Westwego, LA 70094	E-MAIL ADDRESS:	
	INSURER(S) AFFORDING COVERAGE	NAIC #
	INSURER A: Zurich American Insurance Company	16535
	INSURER B: National Union Fire Insurance Company	19445
	INSURER C:	
	INSURER D:	
	INSURER E:	
	INSURER F:	

COVERAGES

CERTIFICATE NUMBER:

REVISION NUMBER:

THIS IS TO CERTIFY THAT THE POLICIES OF INSURANCE LISTED BELOW HAVE BEEN ISSUED TO THE INSURED NAMED ABOVE FOR THE POLICY PERIOD INDICATED. NOTWITHSTANDING ANY REQUIREMENT, TERM OR CONDITION OF ANY CONTRACT OR OTHER DOCUMENT WITH RESPECT TO WHICH THIS CERTIFICATE MAY BE ISSUED OR MAY PERTAIN, THE INSURANCE AFFORDED BY THE POLICIES DESCRIBED HEREIN IS SUBJECT TO ALL THE TERMS, EXCLUSIONS AND CONDITIONS OF SUCH POLICIES. LIMITS SHOWN MAY HAVE BEEN REDUCED BY PAID CLAIMS.

INSR LTR	TYPE OF INSURANCE	ADDL INSD	SUBR WVD	POLICY NUMBER	POLICY EFF (MM/DD/YYYY)	POLICY EXP (MM/DD/YYYY)	LIMITS
A	<input checked="" type="checkbox"/> COMMERCIAL GENERAL LIABILITY <input type="checkbox"/> CLAIMS-MADE <input checked="" type="checkbox"/> OCCUR GEN'L AGGREGATE LIMIT APPLIES PER: <input type="checkbox"/> POLICY <input checked="" type="checkbox"/> PROJECT <input type="checkbox"/> LOC OTHER:	X	X	GLO 3757536 09	02/01/2016	02/01/2017	EACH OCCURRENCE \$ 1,000,000 DAMAGE TO RENTED PREMISES (Ea occurrence) \$ 100,000 MED EXP (Any one person) \$ 10,000 PERSONAL & ADV INJURY \$ 1,000,000 GENERAL AGGREGATE \$ 2,000,000 PRODUCTS - COMP/OP AGG \$ 2,000,000
A	<input checked="" type="checkbox"/> AUTOMOBILE LIABILITY <input type="checkbox"/> ANY AUTO <input type="checkbox"/> ALL OWNED AUTOS <input type="checkbox"/> HIRED AUTOS <input type="checkbox"/> SCHEDULED AUTOS <input type="checkbox"/> NON-OWNED AUTOS	X	X	BAP 3757535 09	02/01/2016	02/01/2017	COMBINED SINGLE LIMIT (Ea accident) \$ 1,000,000 BODILY INJURY (Per person) \$ BODILY INJURY (Per accident) \$ PROPERTY DAMAGE (Per accident) \$
B	<input checked="" type="checkbox"/> UMBRELLA LIAB <input checked="" type="checkbox"/> OCCUR <input type="checkbox"/> EXCESS LIAB <input type="checkbox"/> CLAIMS-MADE DED RETENTION \$	X	X	BE 067907844	02/01/2016	02/01/2017	EACH OCCURRENCE \$ 10,000,000 AGGREGATE \$ 10,000,000
A	WORKERS COMPENSATION AND EMPLOYERS' LIABILITY ANY PROPRIETOR/PARTNER/EXECUTIVE OFFICER/MEMBER EXCLUDED? (Mandatory in NH) If yes, describe under DESCRIPTION OF OPERATIONS below	Y/N N/A	X	WC 3757534 09	02/01/2016	02/01/2017	<input checked="" type="checkbox"/> PER STATUTE <input type="checkbox"/> OTH-ER E.L. EACH ACCIDENT \$ 1,000,000 E.L. DISEASE - EA EMPLOYEE \$ 1,000,000 E.L. DISEASE - POLICY LIMIT \$ 1,000,000

DESCRIPTION OF OPERATIONS / LOCATIONS / VEHICLES (ACORD 101, Additional Remarks Schedule, may be attached if more space is required)

For bid purposes only: River Road Water Line Replacement Phase 2

CERTIFICATE HOLDER

CANCELLATION

Jefferson Parish Council, Jefferson Parish, Louisiana
Jefferson Parish General Gov. Bldg.
200 Derbigny Street, Suite 4400
Gretna, LA 70053

SHOULD ANY OF THE ABOVE DESCRIBED POLICIES BE CANCELLED BEFORE THE EXPIRATION DATE THEREOF, NOTICE WILL BE DELIVERED IN ACCORDANCE WITH THE POLICY PROVISIONS.

AUTHORIZED REPRESENTATIVE

© 1988-2014 ACORD CORPORATION. All rights reserved.

BID BOND

KNOW ALL MEN BY THESE PRESENTS that we, the undersigned,

Wallace C. Drennan, Inc.
as PRINCIPAL, and

The Hanover Insurance Company
as SURETY, are held and firmly bound unto the Parish of Jefferson, hereinafter called the "OWNER", in the penal sum of:

Five Percent (5%) of the Amount Bid

DOLLARS (\$ 5%) lawful money of the United States, for the payment of which sum well and truly to be made, we bind ourselves, our heirs, executors, administrators, successors, and assigns, jointly and severally, firmly by these presents.

THE CONDITION OF THIS OBLIGATION IS SUCH, that whereas the Principal has submitted the accompanying Bid dated October 25, 2016, for

RIVER ROAD WATER LINE REPLACEMENT
RIVET BOULEVARD TO WILLWOOD LANE
BID PROPOSAL NO. 50-00117630

NOW, THEREFORE, if the Principal shall not withdraw said Bid within the period specified therein after the opening of the same or, if no period be specified, within forty-five (45) days after the said opening, and shall within the period specified therefore or, if no period be specified, within twelve (12) days after the prescribed forms are presented to him for signature, enter into a written Contract with the Parish in accordance with the Bid as accepted, and give bond with good and sufficient surety or sureties, as may be required, for the faithful performance and proper fulfillment of such Contract; or in the event of the withdrawal of said Bid within the period specified, or the failure to enter into such Contract and give such bond within the time specified, if the Principal shall pay the Parish the difference between the amount specified in said Bid and the amount for which the Parish may procure the required work or supplies, or both, if the latter be in excess of the former, then the above obligation shall be void and of no effect, otherwise, to remain in full force and virtue.

IN WITNESS WHEREOF, the above bounded parties have executed this instrument under their several seals this 25th day of October, 2016, the name and corporate seal of each corporate party being hereto affixed and these presents signed by its undersigned representative, pursuant to authority of its governing body.

BID BOND (continued)

In Presence of:

Wallace C. Drennan, III

(Individual Principal)

P.O. Box 15438, New Orleans, LA 70175-5438

(Business Address, including Zip Code)

(Partnership)

(SEAL)

(Business Address, including Zip Code)

ATTEST:

BY: Wallace C. Drennan, III

Wallace C. Drennan, Inc.

(Corporate Principal)

P.O. Box 15438, New Orleans, LA 70175

(Business Address, including Zip Code)

BY: _____
AFFIX CORPORATE

SEAL

ATTEST:

(See Power of Attorney)

The Hanover Insurance Company

(Corporate Surety)

440 Lincoln Street, Worcester, MA 01653

(Business Address, including Zip Code)

BY: Pamela K. Tucker
AFFIX CORPORATE SEAL
Pamela K. Tucker, Attorney-in-Fact

Countersigned:

BY: Pamela K. Tucker

Pamela K. Tucker, Attorney-in-Fact*

State of Louisiana

THE HANOVER INSURANCE COMPANY
MASSACHUSETTS BAY INSURANCE COMPANY
CITIZENS INSURANCE COMPANY OF AMERICA

POWERS OF ATTORNEY
CERTIFIED COPY

KNOW ALL MEN BY THESE PRESENTS: That THE HANOVER INSURANCE COMPANY and MASSACHUSETTS BAY INSURANCE COMPANY, both being corporations organized and existing under the laws of the State of New Hampshire, and CITIZENS INSURANCE COMPANY OF AMERICA, a corporation organized and existing under the laws of the State of Michigan, do hereby constitute and appoint

Stephen L. Cory, Pamela K. Tucker, Jill K. Tucker and/or Melanie Stern

of **Metairie, LA** and each is a true and lawful Attorney(s)-in-fact to sign, execute, seal, acknowledge and deliver for, and on its behalf, and as its act and deed any place within the United States, or, if the following line be filled in, only within the area therein designated any and all bonds, recognizances, undertakings, contracts of indemnity or other writings obligatory in the nature thereof, as follows:

Any such obligations in the United States, not to exceed Forty Million and No/100 (\$40,000,000) in any single instance

and said companies hereby ratify and confirm all and whatsoever said Attorney(s)-in-fact may lawfully do in the premises by virtue of these presents. These appointments are made under and by authority of the following Resolution passed by the Board of Directors of said Companies which resolutions are still in effect:

"RESOLVED, That the President or any Vice President, in conjunction with any Vice President, be and they are hereby authorized and empowered to appoint Attorneys-in-fact of the Company, in its name and as its acts, to execute and acknowledge for and on its behalf as Surety any and all bonds, recognizances, contracts of indemnity, waivers of citation and all other writings obligatory in the nature thereof, with power to attach thereto the seal of the Company. Any such writings so executed by such Attorneys-in-fact shall be as binding upon the Company as if they had been duly executed and acknowledged by the regularly elected officers of the Company in their own proper persons." (Adopted October 7, 1981 - The Hanover Insurance Company; Adopted April 14, 1982 - Massachusetts Bay Insurance Company; Adopted September 7, 2001 - Citizens Insurance Company of America)

IN WITNESS WHEREOF, THE HANOVER INSURANCE COMPANY, MASSACHUSETTS BAY INSURANCE COMPANY and CITIZENS INSURANCE COMPANY OF AMERICA have caused these presents to be sealed with their respective corporate seals, duly attested by two Vice Presidents, this 4th day of November 2011.



THE HANOVER INSURANCE COMPANY
MASSACHUSETTS BAY INSURANCE COMPANY
CITIZENS INSURANCE COMPANY OF AMERICA


Robert Thomas, Vice President


Mark Fitzgerald, Vice President

THE COMMONWEALTH OF MASSACHUSETTS)
COUNTY OF WORCESTER) ss.

On this 4th day of November 2011 before me came the above named Vice Presidents of The Hanover Insurance Company, Massachusetts Bay Insurance Company and Citizens Insurance Company of America, to me personally known to be the individuals and officers described herein, and acknowledged that the seals affixed to the preceding instrument are the corporate seals of The Hanover Insurance Company, Massachusetts Bay Insurance Company and Citizens Insurance Company of America, respectively, and that the said corporate seals and their signatures as officers were duly affixed and subscribed to said instrument by the authority and direction of said Corporations.



BARBARA A. GARLICK
Notary Public
Commonwealth of Massachusetts
My Commission Expires Sept. 21, 2018


Barbara A. Garlick, Notary Public
My Commission Expires September 21, 2018

I, the undersigned Vice President of The Hanover Insurance Company, Massachusetts Bay Insurance Company and Citizens Insurance Company of America, hereby certify that the above and foregoing is a full, true and correct copy of the Original Power of Attorney issued by said Companies, and do hereby further certify that the said Powers of Attorney are still in force and effect.

This Certificate may be signed by facsimile under and by authority of the following resolution of the Board of Directors of The Hanover Insurance Company, Massachusetts Bay Insurance Company and Citizens Insurance Company of America.

"RESOLVED, That any and all Powers of Attorney and Certified Copies of such Powers of Attorney and certification in respect thereto, granted and executed by the President or any Vice President in conjunction with any Vice President of the Company, shall be binding on the Company to the same extent as if all signatures therein were manually affixed, even though one or more of any such signatures thereon may be facsimile." (Adopted October 7, 1981 - The Hanover Insurance Company; Adopted April 14, 1982 - Massachusetts Bay Insurance Company; Adopted September 7, 2001 - Citizens Insurance Company of America)

GIVEN under my hand and the seals of said Companies, at Worcester, Massachusetts, this 25th day of October, 2016

THE HANOVER INSURANCE COMPANY
MASSACHUSETTS BAY INSURANCE COMPANY
CITIZENS INSURANCE COMPANY OF AMERICA


Glenn Margosian, Vice President

CERTIFIED COPY OF
EXCERPT OF MINUTES OF A SPECIAL MEETING
OF THE BOARD OF DIRECTORS OF
WALLACE C. DRENNAN, INC.

Held on April 5, 2016
1500 Nine Mile Point Road
Westwego, LA

I, Teresa S. Deemer, Secretary of Wallace C. Drennan, Inc., do hereby certify the following to be a true and correct excerpt of the minutes of the meeting of the Directors of the Corporation held on April 5, 2016; and that the following RESOLUTIONS passed at that meeting are still in full force and effect:

* * *

"...it was further RESOLVED that the President, Wallace C. Drennan, III, be authorized to act for Wallace C. Drennan, Inc., in all phases of the operations of its business, to sign all contracts, bid applications and bids, to manage the business of the corporation, to make loans, execute banking resolutions, sign checks, deposit and withdraw funds, execute payment and performance bonds, make purchase of vehicles, equipment, materials and supplies for the corporation; to sell vehicles, equipment materials and supplies of the corporation; or lease or purchase movable or immovable property and improvements on behalf of the corporation; to hire and fire employees; to manage and oversee construction jobs; to estimate and submit bids; to procure advertising packets, bid packages and other documents necessary to formulate bids for construction work; to manage and oversee the maintenance, scheduling and uses of equipment within the corporation; to direct, manage and supervise labor and construction work; generally, without limitation, to sign all documents and perform all acts necessary for the conducting of the operation and business of Wallace C. Drennan, Inc., as its President; and also the President should have general and specific powers on behalf of the corporation to carry out and work with the Secretary of the corporation in carrying out the banking business of the corporation; to deposit and withdraw funds; to make loans, to sign checks in accordance with the banking resolution contained hereinbelow; to execute mortgages or chattel mortgages, or documents pursuant to the Uniform Commercial Code as necessary to purchase equipment, materials or property;

to execute all necessary banking documents, banking resolutions, loan documents, drafts, continuing guaranties, or other banking documents; and generally to perform any act and execute any document necessary to carry out the banking and financial business of Wallace C. Drennan, Inc., in cooperation with the duties and responsibilities of the Secretary of the corporation."

* * *

Westwego, Louisiana



Teresa S. Deemer
Secretary

CERTIFICATE

I, the undersigned President of Wallace C. Drennan, Inc., do certify that the above and foregoing resolution was unanimously adopted at a meeting of the Board of Directors of the Said Corporation held on April 5, 2016, and that the same is in full force and effect this date.

IN TESTIMONY WHEREOF, I have hereunto set my hand and the seal of said corporation this 4th day of October, 2016.



Wallace C. Drennan, III
President

STATE OF LOUISIANA
PARISH OF ST. TAMMANY

BEFORE ME, the undersigned authority, duly commissioned and qualified and sworn in and for the State and Parish aforesaid, personally came and appeared Wallace C. Drennan, III, President who after being duly sworn, did depose and say as follows:

LA. R.S. 38:2212.10(C) VERIFICATION OF EMPLOYEES INVOLVED IN CONTRACTS FOR PUBLIC WORKS

- A. At the time of bidding, bidder is registered and participates in a status verification system to verify that all new hires in the state of Louisiana are legal citizens of the United States or are legal aliens.
- B. If awarded the contract, bidder shall continue, during the term of the contract, to utilize a status verification system to verify the legal status of all new employees in the state of Louisiana.
- C. If awarded the contract, bidder shall require all subcontractors to submit to it a sworn affidavit verifying compliance with Paragraphs (A) and (B) of this Subsection.


LA. R.S. 38:2224 NON-COLLUSION AND NON-SOLICITATION

- A. The bidder employed no person, corporation, firm, association, or other organization, either directly or indirectly, to secure the public contract under which he received payment, other than persons regularly employed by the bidder whose services in connection with the construction of the public building or project or in securing the public contract were in the regular course of their duties for bidder.
- B. That no part of the contract price received by bidder was paid or will be paid to any persons, corporation, firm, association, or other organization for soliciting the contract, other than the payment of their normal compensation to persons regularly employed by the bidder whose services in connection with construction of the public building or project were in the regular course of their duties for bidder.
- C. Said bid is genuine and the bidder has not colluded, conspired, or agreed, directly or indirectly, with any other bidder to offer a sham or collusive bid.
- D. Said bidder has not in any manner, directly or indirectly, agreed with any other person to fix the bid price of affiant or any other bidder, or to fix any overhead profit or cost element of said bid price, or that of any other bidder, or to induce any other person to refrain from bidding.
- E. Said bidder is not intended to secure an unfair advantage of benefit from the Owner or in favor of any person interested in the proposed contract.
- F. All statements contained in said bid are true and correct.
- G. Neither affiant nor any member of his company has divulged information regarding said bid or any data relative thereto to any other person, firm, or corporation.

LA. R.S. 38:2227 PAST CRIMINAL CONVICTIONS OF BIDDERS

- A. No sole proprietor or individual partner, incorporator, director, manager, officer, organizer, or member who has a minimum of a ten percent (10%) ownership in the bidding entity named below has been convicted of, or has entered a plea of guilty or nolo contendere to any of the following state crimes or equivalent federal crimes as listed below:
 - (a) Public bribery (R.S. 14:118)
 - (b) Corrupt influencing (R.S. 14:120)
 - (c) Extortion (R.S. 14:66)
 - (d) Money laundering (R.S. 14:23)
- B. Within the past five years from the project bid date, no sole proprietor or individual partner, incorporator, director, manager, officer, organizer, or member who has a minimum of a ten percent (10%) ownership in the bidding entity named below has been convicted of, or has entered a plea of guilty or nolo contendere to any of the following state crimes or equivalent federal crimes, during the solicitation or execution of a contract or bid awarded pursuant to the provisions of Chapter 10 of Title 38 of the Louisiana Revised Statutes:
 - (a) Theft (R.S. 14:67)
 - (b) Identity Theft (R.S. 14:67.16)
 - (c) Theft of a business record (R.S. 14:67.20)
 - (d) False accounting (R.S. 14:70)
 - (e) Issuing worthless checks (R.S. 14:71)
 - (f) Bank fraud (R.S. 14:71.1)
 - (g) Forgery (R.S. 14:72)
 - (h) Contractors; misapplication of payments (R.S. 14:202)
 - (i) Malfeasance in office (R.S. 14:134)


I hereby certify that the information herein is true and correct to the best of my knowledge, information, and belief.

Witnesses:


Signature: Wallace C. Drennan, III
Printed Name: Wallace C. Drennan, III
Title: President
Entity Name: Wallace C. Drennan, Inc.

Sworn to and subscribed before me on 19th day of September, 2016.

KEVIN M. POCHE
Attorney/Notary Public
State of Louisiana
Bar No. 33630

Notary Public: 
Commission expires: at death

Public Works Bid

AFFIDAVIT

STATE OF Louisiana

PARISH/COUNTY OF St. Tammany

BEFORE ME, the undersigned authority, personally came and appeared: _____

Wallace C. Drennan, III, (Affiant) who after being by me duly sworn, deposed and said that he/she is the fully authorized President of Wallace C. Drennan, Inc. (Entity), the party who submitted a bid in response to Bid Number 50-00117630, to the Parish of Jefferson.

Affiant further said:

Campaign Contribution Disclosures

(Choose A or B, if option A is indicated please include the required attachment):

Choice A _____ Attached hereto is a list of all campaign contributions, including the date and amount of each contribution, made to current or former elected officials of the Parish of Jefferson by Entity, Affiant, and/or officers, directors and owners, including employees, owning 25% or more of the Entity during the two-year period immediately preceding the date of this affidavit or the current term of the elected official, whichever is greater. Further, Entity, Affiant, and/or Entity Owners have not made any contributions to or in support of current or former members of the Jefferson Parish Council or the Jefferson Parish President through or in the name of another person or legal entity, either directly or indirectly.

Choice B X there are **NO** campaign contributions made which would require disclosure under Choice A of this section.

Affiant further said:

Debt Disclosures

(Choose A or B, if option A is indicated please include the required attachment):

Choice A _____ Attached hereto is a list of all debts owed by the affiant to any elected or appointed official of the Parish of Jefferson, and any and all debts owed by any elected or appointed official of the parish to the Affiant.

Choice B X There are **NO** debts which would require disclosure under Choice A of this section.

Affiant further said:

That Affiant has employed no person, corporation, firm, association, or other organization, either directly or indirectly, to secure the public contract under which he received payment, other than persons regularly employed by the Affiant whose services in connection with the construction, alteration or demolition of the public building or project or in securing the public contract were in the regular course of their duties for Affiant; and

That no part of the contract price received by Affiant was paid or will be paid to any person, corporation, firm, association, or other organization for soliciting the contract, other than the payment of their normal compensation to persons regularly employed by the Affiant whose services in connection with the construction, alteration or demolition of the public building or project were in the regular course of their duties for Affiant.

Affiant further said:

Affiant personally has not been convicted of, nor has he/she entered into a plea of guilty or nolo contendere to any of the crimes or equivalent federal crimes listed below. No individual partner, incorporator, director, manager, officer, organizer, or member, who has a minimum of a ten percent ownership in the Bidding Entity, has been convicted of, or has entered a plea of guilty or nolo contendere to any of the crimes or equivalent federal crimes listed below. A conviction of or plea of guilty or nolo contendere to the following state crimes or equivalent federal crimes shall permanently bar any person or the bidding entity from bidding on public projects:

- (a) Public bribery (R.S. 14:118)
- (b) Corrupt influencing (R.S. 14:120)
- (c) Extortion (R.S. 14:66)
- (d) Money laundering (R.S. 14:230)

A conviction of or plea of guilty or nolo contendere to the following state crimes or equivalent federal crimes shall bar any person or the bidding entity from bidding on public projects for a period of five years from the date of conviction or from the date of the entrance of the plea of guilty or nolo contendere:

- (a) Theft (R.S. 14:67)
- (b) Identity Theft (R.S. 14:67, 16)
- (c) Theft of a business record (R.S. 14:67.20)
- (d) False accounting (R.S. 14:70)
- (e) Issuing worthless checks (R.S. 14:71)
- (f) Bank fraud (R.S. 14:71.1)
- (g) Forgery (R.S. 14:72)
- (h) Contractors; misapplication of payments (R.S. 14:202)
- (i) Malfeasance in office (R.S. 14:134)

The five-year prohibition provided for in this section shall apply only if the crime was committed during the solicitation or execution of a contract or bid awarded pursuant to these provisions. If evidence is submitted substantiating that a false attestation has been made and the project must be readvertised or the contract cancelled, the awarded entity making the false attestation shall be responsible to the public entity for the costs of rebidding, additional costs due to increased costs of bids and any and all delay costs due to the rebid or cancellation of this project.

[The remainder of this page is intentionally left blank.]

Affiant further said:

- (1) Entity is registered and participates in a status verification system to verify that all employees in the State of Louisiana are legal citizens of the United States or are legal aliens.
- (2) Entity shall continue, during the term of the contract, to utilize a status verification system to verify the legal status of all new employees in the State of Louisiana.
- (3) Entity shall require all subcontractors to submit to the Entity a sworn affidavit verifying compliance with statements (1) and (2).

Wallace C. Drennan, III
Signature of Affiant

Wallace C. Drennan, III
Printed Name of Affiant President

SWORN AND SUBSCRIBED TO BEFORE ME

ON THE 19th DAY OF September, 2016.

[Signature]
Notary Public

Kevin M. Poche
Printed Name of Notary

33630
Notary/Bar Roll Number

My commission expires at death.

KEVIN M. POCHÉ
Attorney/Notary Public
State of Louisiana
Bar No. 33630
My commission expires at death



CENTRALBIDDING
FROM CENTRAL AUCTION HOUSE

5000117630 RIVER ROAD WATER LINE REPLACEMENT PHASE 2
Jefferson Parish Government

Project documents obtained from www.CentralBidding.com

29-Sep-2016 02:09:21 PM

Waller (N)

CONTRACT DOCUMENTS, SPECIFICATIONS
AND
CONTRACT DRAWINGS
FOR

JEFFERSON PARISH
DEPARTMENT OF WATER
RIVER RD. WATERLINE REPLACEMENT
RIVET BLVD. TO WILLSWOOD LANE
PROJECT NO. 2015-049-WR
PROPOSAL NO. 50-00117630

ADDENDUM NO. 1

DATE ISSUED: September 29, 2016

BID DATE: October 4, 2016 at 2:00 PM
BID LOCATION: Jefferson Parish General Government Building
Jefferson Parish Purchasing Dept., Suite 4400
200 Derbigny St., Gretna, LA 70053

This addendum shall be part of the Contract Documents as provided in the Instructions to Bidders.

The following items are issued to add to, modify, and clarify the Contract Documents. These items shall have full force and effect as the Contract Documents, and the cost involved shall be included in the bid prices.

Acknowledge receipt of the addendum by inserting its number and date on the Bid Form of the Bid Documents. Failure to do so may subject the bidder to disqualifications.

This Addendum No. 1 consists of 41 pages including the title sheet and all attachments.

Bid Proposal No. 50-00117630



Addendum No. 1

Pre-Bid

A pre-bid conference was held on September 26, 2016 at 10:00 am. The pre-bid meeting memorandum and sign-in sheet are provided as attachments to this addendum.

General

This project is funded through a Louisiana Department of Health and Hospitals Drinking Water Revolving Loan. The project is subject to the Davis Bacon Act and the Davis Bacon Wage Decision. The most recently updated Davis Bacon Wage Decision is included in the specifications and these minimum wages will be required for the listed job classifications on this project.

In some locations it may be necessary to remove and replace existing fencing along the right of way to install the new waterline. Approval shall be obtained from the Engineer before any fence can be removed for waterline installation. The permanent fence along the right of way shall be returned to its original condition following installation of the water line in locations where fence is removed. A fencing bid item for any kind of existing fence has been added to the bid form and will be paid for on a linear foot basis.

Items have been added to the project for handicap ramps and concrete roadway, walks and curb removal and replacement. Details for these items are included as an attachment to this addendum. Only the details that apply to this project in these attachments shall be used.

Handicap ramps will be installed in locations directed by the Engineer. Approval shall be obtained from the Engineer before any handicap ramps are installed. The handicap ramp bid item shall cover all three types of handicap ramps shown in the standard details. It will be at the discretion of the Owner as to which type of handicap ramp will be installed.

A permit from the Southeast Louisiana Flood Protection Authority (SLFPA) – West has been applied for. This permit typically outlines trenching and excavation requirements in relation to the stage of the Mississippi River. The permit has not yet been issued. A letter of no objection that was issued by the US Army Corps of Engineers New Orleans District is attached as reference for stipulations that will be required in the SLFPA West permit. One of the stipulations is that drilling fluid will not be allowed in the directional drilling process. Directional drilling has been removed from the project and waterline in previously proposed directional drill locations shall be installed by open-cut installation. Another critical stipulation is that all excavation work is performed and backfilled while the state of the Mississippi River is below elevation +11.0 feet on the Carrollton gage, at New Orleans, Louisiana. All excavations need to be backfilled to natural ground prior to the river stage rising to +11.0 feet on the Carrollton gage, at New Orleans, Louisiana.

On the day the Carrollton gage reaches +11.0 feet contract time will be suspended. Contract time will resume on the day the Carrollton gage recedes below +11.0.

A permit from the Louisiana Department of Transportation and Development (DOTD) has been applied for. The engineer is currently coordinating with DOTD on the issuance of this permit.

Front Ends

Important Notice to All Bidders

Attached to this addendum is an updated Important Notice to All Bidders.

Louisiana Uniform Public Work Bid Form

A revised bid form dated September 29, 2016 with adjusted quantities for items 202-02-06100, 706-02-00200, W-112, W-412, W-807, W-810 and W-901 is included. Bid Items S-010, 202-02-02021, 202-02-06200, 601-01-00300, 706-01-00100, 706-04-00100, and 707-01-00100 were also added. This revised form shall be used to submit bids on this project.

Table of Contents

Section 02690 - Clearance in the Table of Contents is only one page in lieu of the four pages shown in the Table of Contents.

Technical Specifications

Measurement and Payment Section 01025

Section 01025-4.13 Mobilization (Item No. 727-01-00100) third paragraph. Replace the words "maximum of 5 percent of the total contract" with "maximum of 10 percent of the total contract".

Section 01025-4.33 Waterline (HDPE) (Directional Drill) (ITEM No. NS-P26-23180) shall be removed and replaced with the following:

4.33 HANDICAPPED CURB RAMPS (ITEM NO. 706-04-00100)

- A. Measurement: Measurement for payment for handicapped curb ramps will be made by the actual field measurement on a per each basis.
- B. Payment: Payment for this item will be made for the actual number of ramps installed as determined by the field measurement and will be paid at the unit price bid. The work will include installation, labor, equipment, tools and materials.

Add the following to the end of the Measurement and Payment Section:

4.35 FENCING ANY KIND (ITEM NO. S-010)

- A. Measurement: Measurement for payment for fencing any kind will be made by the actual field measurement on a linear foot removed and replaced basis.

- B. Payment: Payment will constitute full payment for removal and replacement of any kind of existing fence along the length of the project right of way. The actual total linear feet of fence removed and replaced shall include all labor, materials, tools, and equipment necessary to layout and install fence of any kind along the project right of way.

4.36 REMOVAL OF PORTLAND CEMENT CONCRETE PAVEMENT (ITEM NO. 202-02-0202)

- A. Measurement: Measurement for payment for removal of portland cement concrete pavement will be made by field measurement on a square yard basis for removal of portland cement concrete roadway.
- B. Payment: Payment for removal of portland cement concrete pavement will be made at the square yard price bid and will constitute full compensation for providing all labor and equipment for the removal and proper disposal of any material to be removed. Unit price shall include any saw cutting required for removal of pavement.

4.37 REMOVAL OF CONCRETE WALK (ITEM NO. 202-02-06200)

- A. Measurement: Measurement for payment for removal of portland cement concrete walks will be made by field measurement on a square yard basis for removal of portland cement concrete walks.
- B. Payment: Payment for removal of portland cement concrete walks will be made at the square yard price bid and will constitute full compensation for providing all labor and equipment for the removal and proper disposal of any material to be removed. Unit price shall include any saw cutting required for removal of pavement.

4.38 PORTLAND CEMENT CONCRETE (9" THICK) (ITEM NO. 601-01-00300)

- A. Measurement: Measurement for Portland Cement Concrete will be made by the actual field measurement on a square yard basis.
- B. Payment: Payment for this item will be made for the actual square yardage installed as determined by the field measurement and will be paid at the unit price bid. The work will include installation, labor, equipment, tools and materials.

4.39 CONCRETE WALK (4" THICK) (ITEM NO. 706-01-00100)

- A. Measurement: Measurement for payment for concrete walks will be made by the actual field measurement on a square yard basis.
- B. Payment: Payment for this item will be made for the actual square yardage installed as determined by the field measurement and will be paid at the unit price bid. The work will include installation, labor, equipment, tools, and materials.

4.40 REMOVE AND REPLACE CONCRETE CURB (ITEM NO. 707-01-00100)

- A. Measurement: Measurement for payment for removal and replacement of concrete curb will be made by the actual field measurement of curb removed and replaced.
- B. Payment: Payment for this item will be made for the actual linear feet of concrete curb removed and replaced as determined by field measurement and will be paid at the unit price bid. The work will include removal, proper disposal, installation, labor, equipment, tools and materials.

Plans

Sheet No. 4

Quantities have been updated and a new items added.

Sheet No. 9

Horizontal directional drill has been changed to open-cut installation and the air release valve was removed.

Sheet No. 10

Horizontal directional drill has been changed to open-cut installation.

Sheet No. 16

Horizontal directional drill has been changed to open-cut installation.

Sheet No. 25

Tie-in details at Modern Farms Rd. have been revised.

Note: The following items are attached and are hereby made part of this addendum:

- a) Pre-Bid Conference Agenda
- b) Pre-Bid Conference Sign-In Sheet
- c) Contractors' questions submitted in writing
- d) Revised Sheet Nos. 4, 9, 10, 16, and 25
- e) Revised Louisiana Uniform Public Work Bid Form
- f) Bidding Procedures
- g) US Army Corps of Engineers Letter of No Objection
- h) Important Notice to All Bidders – Bid Requirements
- i) Plan Holders List
- j) Jefferson Parish Roadway, Driveway and Sidewalk Details

k) DOTD Rural Driveway Details

END OF ADDENDUM

AGENDA
PRE-BID MEETING
JEFFERSON PARISH DEPARTMENT OF WATER
RIVER RD. WATERLINE REPLACEMENT PHASE 2
WILLSWOOD LANE TO RIVET BLVD

SEPTEMBER 26, 2016

Location:

**Jefferson Parish Purchasing Department Conference Room
200 Derbigny Street, Suite 4400
Gretna, LA 70053**

I. Project Overview

Scope:

Base Bid: The work of this contract includes construction and installation of a 12-inch water line along River Road in Waggaman, LA. The waterline will begin at the intersection of Willswood Lane and River Road and will parallel River Road until reaching the tie-in location approximately 570 ft. east of the centerline of the intersection of Rivet Boulevard and River Road. The contract shall be constructed complete in place with all valves, hydrants, fittings, and services and restoration of roadway, roadway drainage ditches, driveways and sidewalks to original conditions.

Time of Construction: 180 calendar days

Engineer's Cost Estimate: \$1,885,700

II. Coordination with Jefferson Parish & Engineers

- a) Digital Engineering Contact – Rob Delaune – Project Manager (504-468-6129)
rdelaune@deii.net
- b) Jefferson Parish Water Department – Sal Maffei – Dept. Director (504-736-6060)
- c) Jefferson Parish Water Department – Doug Pertuit – Asst. Director (504-736-6060)
- d) Purchasing Department – Sidney Duffy – Assigned Buyer (504-364-2682)

III. Issuance of Addenda

All technical questions will be made in writing (preferably email) to Rob Delaune of Digital Engineering, Inc. Responses cannot be guaranteed for any questions posed within 72 hours of the Bid Date (Tuesday, October 4, 2016).

All addenda shall be submitted to purchasing for approval prior to distribution.

IV. Bid Opening – Bids will be received until 2:00 PM, October 4, 2016 in the Purchasing Department, Jefferson Parish General Government Building.

The Office Hours for the Purchasing Department are Monday, Friday 8:30 am to 4:30 pm. Please opt to drop off the bids or mail them in.

In the delivery of the bid, please remember to make sufficient time to find parking and deliver the bid, keeping in mind that the government building has metal detectors at the entrance. Late Bids will not be accepted.

On the outside of the bid package envelope, please provide the company name and address, bid number, and the company's license number.

On the inside of the bid package envelope, please include the completed bid form, a corporate resolution (if the signature on the bid form is not of a company officer), and 5% surety bond, signed in original ink. Any corrections must be initialed by bid signee. If you do not have a corporate resolution form, please download the one provided on the Jefferson Parish Website – www.jeffparish.net

On the public bid form, please acknowledge the receipt of all addenda.

V. Coordination Efforts with Jefferson Parish

- a) Water service must remain in effect at all times during construction. Any water service interruptions will have to be approved in advance in writing by the Jefferson Parish Water Department.

VI. Permits

- a) Pontchartrain Levee District Permit
- b) LDOTD Utility Permit

VII. Contractor questions

PRE-BID CONFERENCE SIGN-IN SHEET

BID #: 50-00117630 DESCRIPTION: River Road Water Line replacement (Rivert Blvd. to Willswood Lane) for the Department of Water
 LOCATION: GGB, STE. 3503/3506
 DATE AND TIME: September 26, 2016 @ 10:00 AM
 START TIME: STOP TIME:

COMPANY NAME/ADDRESS	COMPANY REPRESENTATIVE	PHONE/FAX NO.	EMAIL ADDRESS	SIGN-IN TIME
JEFFERSON PARISH PURCHASING DEPARTMENT	Ms. Sidney Duffy, Buyer II	PH: 504-364-2682 Fax: 504-364-2693	sduffy@jeffparish.net	10:00 AM
Cycle Construction 60 East 3rd St. Kamptulaton	Charlie Cerkin	(504) 467-1444 (504) 467-1222	cgerkin@cycleconstruction.com	9:42 am
Digital Engineering 527 W. Esplanade Ave. 70005 Suite 200 Metairie, LA	Rob Delanne	504-468-6129 504-461-5150	rdelanne@dei.net	9:43 AM
Bob Bros. Const. Co. 730 S. TONY New Orleans, LA 70114	Brian Boehm	504-827-7635 504-821-0714	bboehm@bobbrothers.com	9:51 AM
JP Water 1221 Elmwood Park Blvd Metairie, LA 70153	Jerome Wool	504-736-6747 504-736-6855	jwool@jeffparish.net	9:52 AM
COMMANO CONSTRUCTION 3206 N. TURNBULL DR METAIRIE, LA 70002	BRIAN BAUDIER	504 887-8295 FAX 504 887-8906	STACIE@COMMANOINDUSTRIES.COM	9:56 AM
GLOBAL INDUSTRIAL CONTRACTORS 1722 LOBBELL PORT ALLEN, 70767	SCOTT E. GUYERIN	225-661-6380	sguy@globalcontractors.com	9:59
Beverly Construction 1214 RIDER RD Briogee City, CA. 70092	LANNY CAZAY	985 264-8725	LANNY@BEVERLYINC.COM	10:00

PRE-BID CONFERENCE SIGN-IN SHEET

BID #: 50-00117630 DESCRIPTION: River Road Water Line replacement (Rivert Blvd. to Williswood Lane) for the Department of Water
 LOCATION: GGB, STE. 3503/3506
 DATE AND TIME: September 26, 2016 @ 10:00 AM
 START TIME: _____ STOP TIME: _____

COMPANY NAME/ADDRESS	COMPANY REPRESENTATIVE	PHONE/FAX NO.	EMAIL ADDRESS	SIGN-IN TIME
JEFFERSON PARISH PURCHASING DEPARTMENT	Ms. Sidney Duffy, Buyer II	PH: 504-364-2682 Fax: 504-364-2693	sduffy@jeffparish.net	
WALLACE DRUMMOND 1500 VINE MILE PT ROAD METairie, LA 70001	Jim Morgan	504-828-8200 836-2939	ESTIMATE@WALLACE-DRUMMOND.COM	10:00 AM
HARD ROCK CONSTRUCTION 2305 C.A. ROAD METairie, LA 70001	Ray Lockwood	504-835-1050 504-837-0490	RAY@HARDROCKCONSTRUCTION.COM	10:00 AM
Tyrell Construction 3600 Jeff Hwy	Tyrell Chuteau	838-4315 401-1301	tchuteau@tyrellconstruction.net	10:00
Dan MacDonald LDA/DURCF	LDH/Durcf	225-392-8126	dmacdonald@ldh.la.gov	10:00

River Rd. Waterline Replacement Phase 2
Willswood Lane to Rivet Blvd.
Contractor Questions and Answers

Command Construction Questions and Answers

Question 1: Please advise on the liquidated damages for the subject project.

Answer 1: The liquidated damages information is located on the second page of the Important Notice to All Bidders – Bid Requirements. Upon notice to proceed the bidder agrees that all work shall be completed within 180 calendar days. The bidder agrees to pay as liquidated damages the sum of \$500 per day each consecutive calendar day after the agreed date of completion that the work remains substantially incomplete.

Question 2: Could you please clarify when the DBA/Debarment/Lobbying forms are to be submitted?

Answer 2: These documents do not have to be submitted with the bid but will be required from the apparent low bidder following the bid opening.

Global Contractors Questions and Answers

Question 1: I found the 180 calendar days for the project but could not locate what the Liquidated Damages are. It was not listed in the "Agreement".

Answer 1: See answer to question 1 under Command Construction Questions and Answers.

Question 2: Would you entertain putting a bid item for Sand? Depths can vary from drawings during installation.

Answer 2: Depths of the waterline installation are shown in the profile of the drawings. Calculate your sand quantity accordingly based on the depths of installation shown. No separate item for sand will be added. It is considered incidental to the unit price.

Question 3: Would you entertain putting an item for fence? The waterline comes fairly close in some spots and the fence will have to be replaced.

Answer 3: Item S-010 Fence Any Kind has been added.

Question 4: What is the existing waterline made of? AC? If so laying the new line next to the AC line is problematic at best. AC pipe is very brittle and also has short pipe lengths (6' I think). If room allows can we shift away for the existing AC waterline to avoid breaking it?

Answer 4: The existing waterline is AC pipe in some locations and cast iron in other locations. The existing waterline locations shown on the plans are approximate and will have to

be verified in the field by the contractor. Any proposed adjustments to the new waterline alignment shall be approved by the Engineer before waterline installation begins.

Question 5: What is the size and type of the two waterlines on Modern Farms Rd? The chart on Sht. 34 calls out 12" connection. Sht. 25 calls out a (2) 12" x 8" Tees which would indicate an 8" line.

Answer 5: The size of the waterline at Sta. 201+52.18 is 12" in diameter. The type will have to be verified in the field by the contractor. A 12"x12"x12" tee will be required for this tie-in. The size of the waterline at Sta. 201+91.58 is 2" and will be paid as a water service connection up to 2".

Question 6: My quantity takeoff for Transition Couplings are as follows: (2) 12", (15) 8" and (1) 6". This does not match the bid item quantity. I assumed Modern Farm had (2) 8" transition couplings not 12.

Answer 6: The quantities have been changed and the changes are included as part of this addendum. The new quantities are (1) 6", (13) 8" and (3) 12".

Question 7: I came up with (45) 12" gate valves. Bid item calls for 42 ea 12" gate valves. I did not assume Modern Farm was 12" as shown on Sht. 34.

Answer 7: The quantity has been changed to (46) 12" gate valves.

Question 8: In the specifications, Instruction to bidders Par. B Price (4)...Is this a tax exempt job?

Answer 8: This project is not sales tax exempt.

Question 9: In the specifications, Instructions to bidders Par. B Price (5)...2%, 10 days...Does this mean 2% discount if paid within 10 days? Does this apply to our invoices?

Answer 9: This does not apply to the Contractor's invoices on this project.

Question 10: Could you please specify all forms that need to be included with the bid?

Answer 10: The Important Notice to All Bidders and the Changes to Jefferson Parish Bidding Procedures documents as part of this addendum specify all forms that need to be included with the bid.

Question 11: Is this a Buy American Project?

Answer 11: No

Question 12: Should the mainline tee be included with the fire hydrant assembly or will it be paid under the fitting item?

Answer 12: The main line tee shall be included with the fire hydrant assembly bid item.

Question 13: Are the ductile iron fittings to be paid by actual weight less accessories?

Answer 13: Yes, ductile iron fittings shall be paid by actual weight. Accessories are considered incidental to the fittings installation.

Boh Bros. Construction Questions and Answers

Question 1: Sheet No. 33 Water and Sewer Force Main Standard Trench Detail Final Backfill Cover lists ***, **** as acceptable backfill materials. Which one should we use? **** says River Sand within Street Right of Way which is property line to property line. So all water lines installed would be within the right of way. *** & **** contradict each other. Also, a large portion of the water line is to be installed in the bottom of the existing ditch and in the slope of the ditch wall. River Sand backfill will surely be washed away as soon as we have a large rain event. Please clarify your intention as it relates to the Final Backfill of the water lines.

Answer 1: All backfill shall be river sand since all installations will be within the street right of way. In the case of waterline installed in the bottom of existing ditches and slopes of the ditch wall river sand will be used as backfill however the top six inches of the trench shall be backfilled with select excavated material to prevent the river sand from washing away during rain events.

Question 2: Will all exiting ground cover that is disturbed to install water line be required to be restored with grass sod or seeding?

Answer 2: Existing established residential lawns will require sod. All other areas will require seed.

Question 3: Page 02230-3 says we should notify St. Bernard Parish Sewer & Water Division? Is this correct?

Answer 3: All references to St. Bernard Parish Sewer and Water Division on page 02230-3 are incorrect. This should be the Jefferson Parish Department of Water. Water General Superintendent, Tyrell Chatman needs to be alerted by the Contractor prior to the performance of any work impacting existing water utility features. Tyrell's office phone number is 838-4315.

Question 4: Page 02230-3 says a Class IV Water Distribution Operator Certificate license shall be required to oversee water line install. Will someone from Jefferson Parish water department have this license and is there any fees associated with same?

Answer 4: The Contractor will have to supply the Class IV Licensed Water Distribution Operator to operate valves or complete a tie-in on any active (live) water distribution or water supply system in the Parish. If the Contractor does not have a Class IV Water Distribution

Operator on staff he can hire a sub-contractor that does have the certification to oversee the installations and provide this required license.

Question 5: Some chain link fences and ornamental fences will be in conflict/close proximity to our water line installation. How will the contractor be compensated to remove/replace any removed/damaged fencing?

Answer 5: An item has been added for fencing.

ITEM NO.	DESCRIPTION	UNIT	QUANTITY
202-02-0010	Removal of Structures & Obstructions	Lump Sum	1
202-02-0200	Removal of Asphalt Pavement	Sq. Yd.	360
202-02-0910	Removal of Concrete Drives	Sq. Yd.	900
202-02-0021	Removal of Portland Cement Concrete Pavement	Sq. Yd.	700
202-02-0020	Remove Concrete Walk	Sq. Yd.	150
202-02-0030	Removal of Asphalt Concrete Pavement	Sq. Yd.	870
204-01-1000	Temporary Erosion Control	Lump Sum	1
602-01-0010	Traffic Maintenance Aggregate (Truck Measure)	Cu. Yd.	180
801-01-0030	Portland Cement Concrete (8" Thick)	Sq. Yd.	750
751-03	24" RCP Driveway Pipe Replacement	Each	1
706-01-0010	Concrete walk (8" Thick)	Sq. Yd.	180
706-04-0010	Handicapped Curb Ramps	Each	4
706-02-0020	Concrete Drive (8" Thick)	Sq. Yd.	900
707-01-0010	Remove And Replace Concrete Curb	Lin. Ft.	500
714-01-0000	State Seeding (St. Augustine)	Sq. Yd.	2800
717-01-0010	Seeding	Lin.	80
727-01-0010	Mulchization	Lump Sum	1
741-11-0020	Adjusting Water Meter Box	Each	30
HS-MNT-20032	Maintenance of Traffic, Temp. Signs, and Baricades	Lump Sum	1
S-002	Exploratory Excavation	Each	40
S-003	Temporary Driveway Ramp	Each	30
S-004	Asphalt Patching	Sq. Yd.	360
S-005	Grid Existing Stamps	Each	2
S-006	Project Sign	Each	2
S-007	Remove and Replace Gravel Drives	Sq. Yd.	325
S-009	Removal of Fire Hydrants	Each	11
S-010	Fence Any Kind	Lin. Ft.	500
W-106	Water Main (8") (PVC C900)	Lin. Ft.	20
W-108	Water Main (8") (PVC C900)	Lin. Ft.	200
W-112	Water Main (12") (PVC C900)	Lin. Ft.	12910
W-206	Water Main (8") (DUCTILE IRON PIPE)	Lin. Ft.	100
W-208	Water Main (8") (DUCTILE IRON PIPE)	Lin. Ft.	100
W-212	Water Main (12") (DUCTILE IRON PIPE)	Lin. Ft.	100
W-406	Gate Valve and Valve Box (8")	Each	1
W-408	Gate Valve and Valve Box (8")	Each	12
W-412	Gate Valve and Valve Box (12")	Each	48
W-706	Pipe Restraints (8")	Each	2
W-708	Pipe Restraints (8")	Each	22
W-712	Pipe Restraints (12")	Each	78
W-806	Transitional Couplings (8")	Each	1
W-807	Transitional Couplings (8")	Each	13
W-810	Transitional Couplings (12")	Each	3
W-901	Outlet Inlet Fittings	Pounds	7500
W-902-A	Pipe Hydrant Assembly	Each	27
W-903-0	Water Service Connection (1")	Each	20
W-903-1	Water Service Connection (1")	Each	10
W-903-2	Water Service Connection (Up to 2" Polyethylene)	Each	10
W-906	Abandonment of Waterline (8")	Lin. Ft.	12910
W-907-6	Removal & Disposal of Existing AC Waterline (8")	Lin. Ft.	200
W-907-8	Removal & Disposal of Existing AC Waterline (8")	Lin. Ft.	200
NS-P55-2300	Air Release Valve V8 Manhole	Each	5



BID PROPOSAL No. 50-00117630
 ADDENDUM No. 1



PROJECT NO.		514-01	
DATE		SEPTEMBER 2018	
SCALE		AS SHOWN	
SHEET NO.		4	
L.A. DEPARTMENT OF HEALTH & HOSPITALS RIVER ROAD WATER LINE REPLACEMENT RIVER BOULEVARD TO PACHA LINE SUMMARY OF ESTIMATED QUANTITIES			

NOTES: 1. ALL STATIONING IS FROM R/W BASELINE "A". 2. PROVIDE 3 FOOT MINIMUM COVER FOR NEW WATERLINE. 3. CONTRACTOR TO LOCATE EXISTING AND FIRE SERVICES IN FIELD AND CONNECT SERVICE TO NEW WATERLINE. 4. WATERLINE FITTING LOCATIONS ARE FOR INFORMATIONAL PURPOSES ONLY. ACTUAL FIELD LOCATIONS MAY VARY. 5. EXISTING 8" WATERLINE MUST REMAIN IN SERVICE AT ALL TIMES DURING CONSTRUCTION. 6. MINIMUM RADIUS FOR DIRECTIONAL DRILL = 25'.

BID PROPOSAL No. 50-00117630
ADDENDUM No.1

NEW 18" S.A. 800 HAS SET IN THE SOUTH FACE OF A POWER POLE LOCATED APPROXIMATELY 1/2 MILE WEST OF ACADIA DRIVE AND 1/2 MILE NORTH OF RIVER ROAD. HAS SHOWN HEREON. BETWEEN 124+15.00 AND 124+15.00.

SCALE: 1"=40'

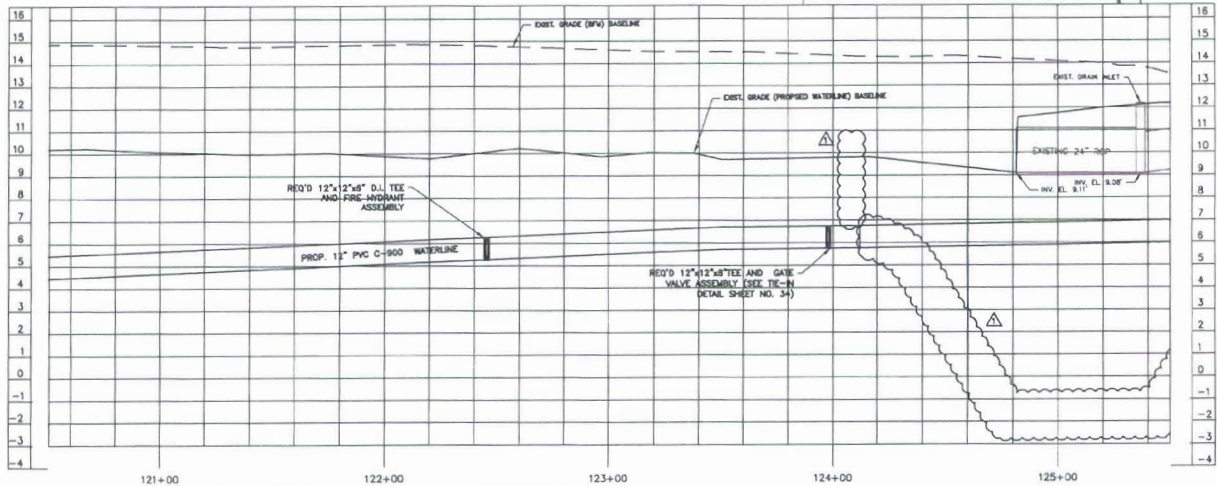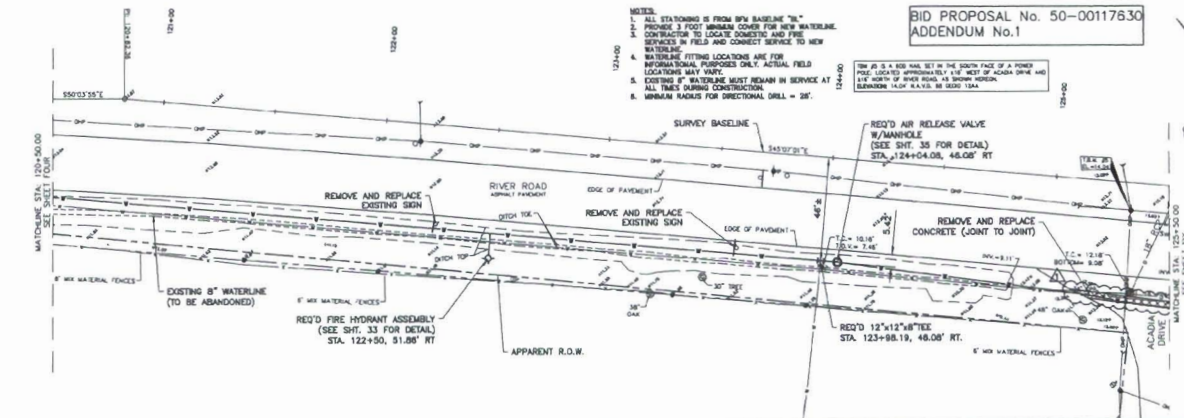


digital engineering
L.A. DEPARTMENT OF HEALTH & HOSPITALS
RIVER ROAD WATER LINE REPLACEMENT
RIVER BOULEVARD TO PARISH LINE
PLAN & PROFILE SHEET
STA. 120+50 TO STA. 125+50
PROJECT NO. 514-B
DATE SEPTEMBER 2016
SCALE
SHEET NO. 9


BID PROPOSAL No. 50-00117630
ADDENDUM No.1

- NOTES:
1. ALL STATIONING IS FROM NEW BASELINE "RL".
 2. PROVIDE 3 FOOT URBAN COVER FOR NEW WATERLINE.
 3. CONTRACTOR TO LOCATE DOMESTIC AND FIRE SERVICES IN FIELD AND CORRECT SERVICE TO NEW WATERLINE.
 4. WATERLINE FITTING LOCATIONS ARE FOR INFORMATIONAL PURPOSES ONLY. ACTUAL FIELD LOCATIONS MAY VARY.
 5. EXISTING 8" WATERLINE MUST REMAIN IN SERVICE AT ALL TIMES DURING CONSTRUCTION.
 6. MINIMUM RADIUS FOR DIRECTIONAL DRILL = 30'.
 7. CONTRACTOR SHALL RE-INSTALL ALL BOLLARDS REMOVED OR DISTURBED DURING CONSTRUCTION AT NO ADDITIONAL COST TO THE OWNER.
 8. CONTRACTOR SHALL REPLACE ALL BOLLARDS DAMAGED DURING CONSTRUCTION AT NO ADDITIONAL COST TO THE OWNER.

SCALE: 1"=20'

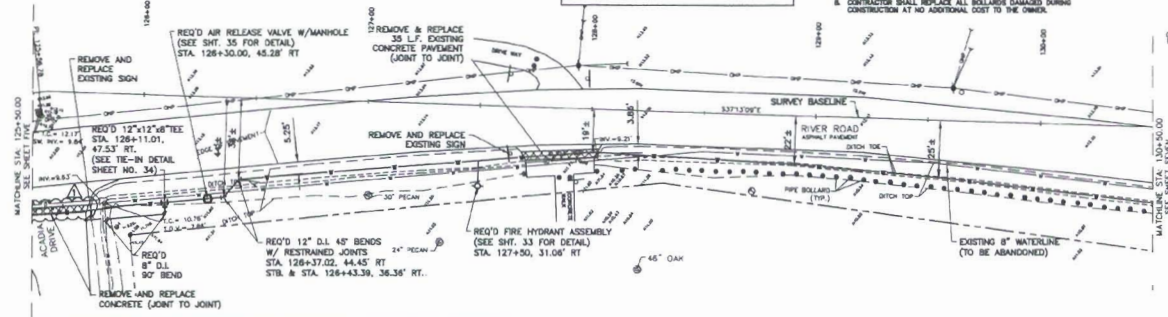

STATE OF LOUISIANA
ROBERT A. JACOBSON, JR.
LICENSE NO. 32507
PROFESSIONAL ENGINEER
CML ENGINEERING
9-29-16

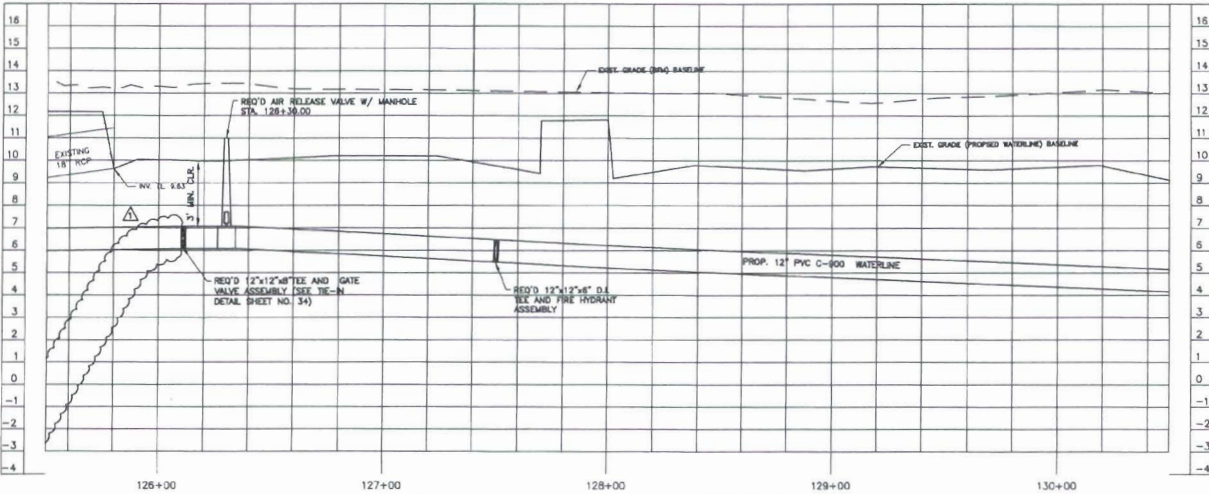



LA DEPARTMENT OF HEALTH & HOSPITALS
RIVER ROAD WATER LINE REPLACEMENT
RIVER BOULEVARD TO PARISH LINE
PLAN & PROFILE SHEET
STA. 125+50 TO STA. 130+50

PROJECT NO. 514-91
DATE: SEPTEMBER 2016
SCALE:
SHEET NO. 10

BID PROPOSAL No. 50-00117630
ADDENDUM No.1

THE 100' IS A 100' WIDE SET IN THE SOUTH FACE OF A POWER
POLE LOCATED APPROXIMATELY 1/2 MILE NORTH OF CHANDLER DRIVE
AND 1/2 EAST OF RIVER ROAD AS SHOWN HEREON.
ELEVATION 14.87' M.A.S.D. BE 5000 134

- NOTES:
1. ALL STATIONING IS FROM NEW BASELINE "B".
 2. PROVIDE 3 FOOT BROWSPAN COVER FOR NEW WATERLINE.
 3. CONTRACTOR TO LOCATE EXISTING AND FIRE SERVICES IN FIELD AND CONNECT SERVICE TO NEW WATERLINE.
 4. WATERLINE FITTING LOCATIONS ARE FOR INFORMATIONAL PURPOSES ONLY. ACTUAL FIELD LOCATIONS MAY VARY.
 5. EXISTING 8" WATERLINE MUST REMAIN IN SERVICE AT 150+00.
 6. MESSAGE RADIUS FOR DIRECTIONAL DRILL = 20'.

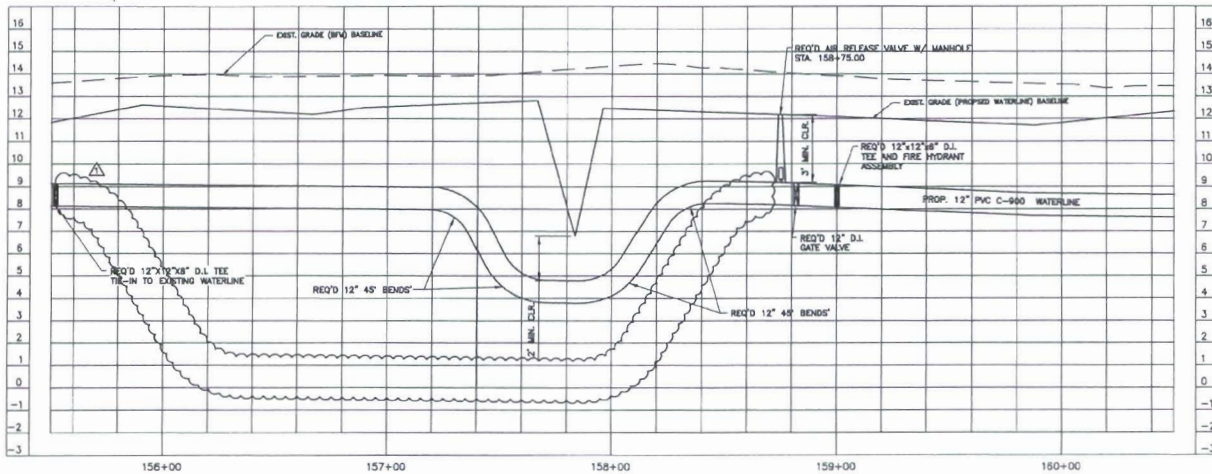
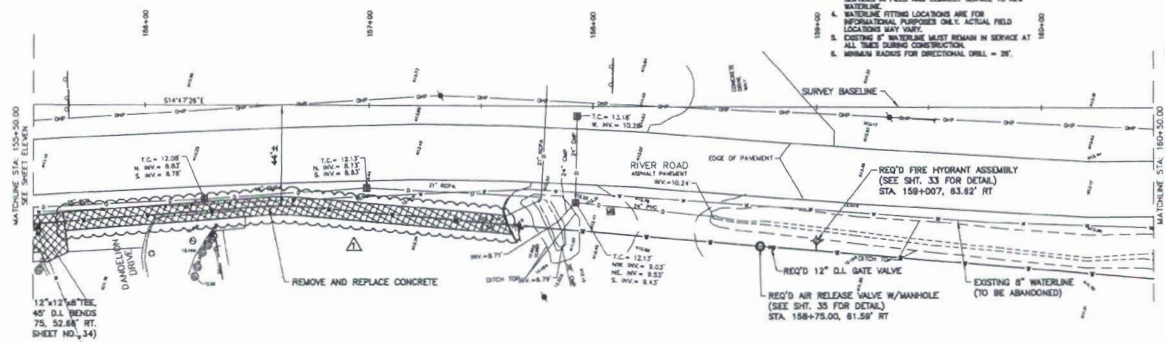


digital engineering
L.A. DEPARTMENT OF HEALTH & HOSPITALS
RIVER ROAD WATER LINE REPLACEMENT
RIVET BOULEVARD TO PARRISH LINE
PLAN & PROFILE SHEET
STA. 155+50 TO STA. 160+50

PROJECT NO. 514-21
DATE: SEPTEMBER 2018
SCALE
SHEET NO. 16

BID PROPOSAL No. 50-00117630
ADDENDUM No.1

- NOTES:
1. ALL STATIONING IS FROM NEW BASELINE "B".
 2. PROVIDE 3 FOOT MINIMUM COVER FOR NEW WATERLINE.
 3. CONTRACTOR TO LOCATE EXISTING AND FIRE SERVICES IN FIELD AND CONNECT SERVICE TO NEW WATERLINE.
 4. WATERLINE FITTING LOCATIONS ARE FOR INFORMATIONAL PURPOSES ONLY. ACTUAL FIELD LOCATIONS MAY VARY.
 5. EXISTING 8" WATERLINE MUST REMAIN IN SERVICE AT ALL TIMES DURING CONSTRUCTION.

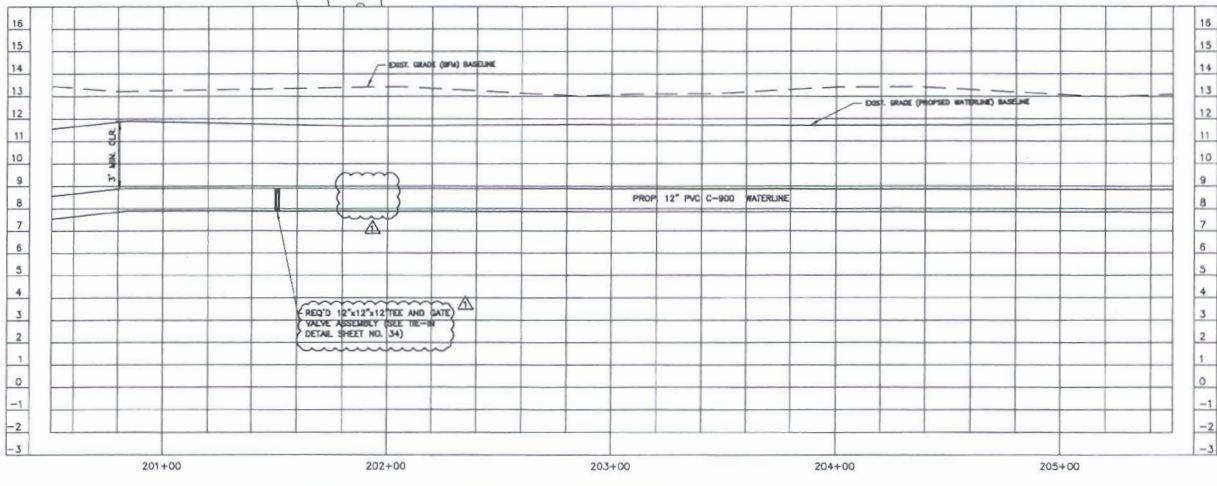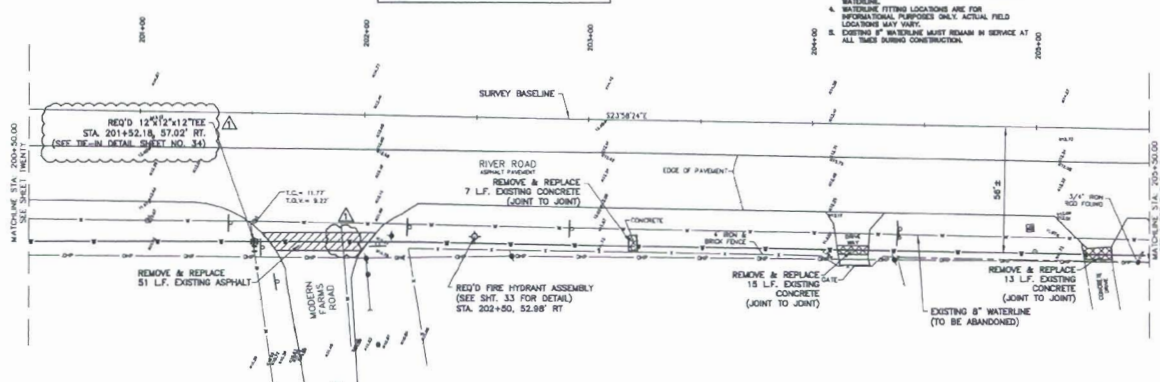

LA DEPARTMENT OF HEALTH & HOSPITALS
RIVER ROAD WATER LINE REPLACEMENT
RIVER BOULEVARD TO PARK LINE
PLAN & PROFILE SHEET
S/A 500558.10 STA. 200+50

PROJECT NO. 514-81
DATE: SEPTEMBER 2016
SCALE
SHEET NO. 25

digital engineering
417 W. BROADWAY AVE. STE. 200 CHICAGO, IL 60601
TEL: 312.555.1234 FAX: 312.555.1235
WWW.DIGITAL-ENGINEERING.COM

LOUISIANA UNIFORM PUBLIC WORK BID FORM

TO: Jefferson Parish Purchasing Department
200 Derbigny Street, Suite 4400
Gretna, Louisiana 70053
ATTN: Purchasing
(Owner to provide name and address of owner)

BID FOR: River Road Waterline Replacement – Phase 2
Willswood Lane to Rivet Blvd.
Public Works Project No. 2015-049-WR
Bid Proposal No. 50-00117630
(Owner to provide name of project and other identifying information)

The undersigned bidder hereby declares and represents that she/he; a) has carefully examined and understands the Bidding Documents, b) has not received, relied on, or based his bid on any verbal instructions contrary to the Bidding Documents or any addenda, c) has personally inspected and is familiar with the project site, and hereby proposes to provide all labor, materials, tools, appliances and facilities as required to perform, in a workmanlike manner, all work and services for the construction and completion of the referenced project, all in strict accordance with the Bidding Documents prepared by: _____

Digital Engineering and dated: 8/01/2016
(Owner to provide name of entity preparing bidding documents.)

Bidders must acknowledge all addenda. The Bidder acknowledges receipt of the following **ADDENDA**: (Enter the number the Designer has assigned to each of the addenda that the Bidder is acknowledging) #1, 9/29/16.

TOTAL BASE BID: For all work required by the Bidding Documents (including any and all unit prices designated "Base Bid" * but not alternates) the sum of:

_____ Dollars (\$ _____)

ALTERNATES: For any and all work required by the Bidding Documents for Alternates including any and all unit prices designated as alternates in the unit price description.

Alternate No. 1 (Owner to provide description of alternate and state whether add or deduct) for the lump sum of:

N/A Dollars (\$ _____)

Alternate No. 2 (Owner to provide description of alternate and state whether add or deduct) for the lump sum of:

N/A Dollars (\$ _____)

Alternate No. 3 (Owner to provide description of alternate and state whether add or deduct) for the lump sum of:

N/A Dollars (\$ _____)

NAME OF BIDDER: Wallace C. Drennan, Inc.

ADDRESS OF BIDDER: P.O. Box 15438
New Orleans, LA 70175-5438

LOUISIANA CONTRACTOR'S LICENSE NUMBER: # 1033

NAME OF AUTHORIZED SIGNATORY OF BIDDER: Wallace C. Drennan, III

TITLE OF AUTHORIZED SIGNATORY OF BIDDER: President

SIGNATURE OF AUTHORIZED SIGNATORY OF BIDDER **: Wallace C. Drennan, III

DATE: October 13, 2016

* The Unit Price Form shall be used if the contract includes unit prices. Otherwise it is not required and need not be included with the form. The number of unit prices that may be included is not limited and additional sheets may be included if needed.

** If someone other than a corporate officer signs for the Bidder/Contractor, a copy of a corporate resolution or other signature authorization shall be required for submission of bid. Failure to include a copy of the appropriate signature authorization, if required, may result in the rejection of the bid unless bidder has complied with La. R.S. 38:2212(B)5.

BID SECURITY in the form of a bid bond, certified check or cashier's check as prescribed by LA RS 38:2218.A is attached to and made a part of this bid.

LOUISIANA UNIFORM PUBLIC WORK BID FORM

UNIT PRICE FORM

TO: Jefferson Parish Purchasing Department
200 Derbigny Street, Suite 4400
Gretna, Louisiana 70053
ATTN: Purchasing
(Owner to provide name and address of owner)

BID FOR: River Road Waterline Replacement – Phase 2
Williswood Lane to Rivet Blvd.
Public Works Project No. 2015-049-WR
Bid Proposal No. 50-00117630
(Owner to provide name of project and other identifying information)

UNIT PRICES: This form shall be used for any and all work required by the Bidding Documents and described as unit prices. Amounts shall be stated in figures and only in figures.

DESCRIPTION:	REMOVAL OF STRUCTURES AND OBSTRUCTIONS	<input checked="" type="checkbox"/> Base Bid or <input type="checkbox"/> Alt.#	UNIT PRICE	UNIT PRICE EXTENSION (Quantity times Unit Price)
REF. NO.	QUANTITY:	UNIT OF MEASURE:		
202-02-00100	1	Lump Sum	\$45,000.00	\$45,000.00

DESCRIPTION:	REMOVAL OF ASPHALT PAVEMENT	<input checked="" type="checkbox"/> Base Bid or <input type="checkbox"/> Alt.#	UNIT PRICE	UNIT PRICE EXTENSION (Quantity times Unit Price)
REF. NO.	QUANTITY:	UNIT OF MEASURE:		
202-02-02000	360	Sq. Yd.		

DESCRIPTION:	REMOVAL OF CONCRETE DRIVES	<input checked="" type="checkbox"/> Base Bid or <input type="checkbox"/> Alt.#	UNIT PRICE	UNIT PRICE EXTENSION (Quantity times Unit Price)
REF. NO.	QUANTITY:	UNIT OF MEASURE:		
202-02-06100	900	Sq. Yd.		

DESCRIPTION:	REMOVAL OF ASPHALTIC CONCRETE PAVEMENT	<input checked="" type="checkbox"/> Base Bid or <input type="checkbox"/> Alt.#	UNIT PRICE	UNIT PRICE EXTENSION (Quantity times Unit Price)
REF. NO.	QUANTITY:	UNIT OF MEASURE:		
202-02-02020	570	Sq. Yd.		

DESCRIPTION:	TEMPORARY EROSION CONTROL	<input checked="" type="checkbox"/> Base Bid or <input type="checkbox"/> Alt.#	UNIT PRICE	UNIT PRICE EXTENSION (Quantity times Unit Price)
REF. NO.	QUANTITY:	UNIT OF MEASURE:		
204-01-10000	1	Lump		

DESCRIPTION:	TRAFFIC MAINTENANCE AGGREGATE	<input checked="" type="checkbox"/> Base Bid or <input type="checkbox"/> Alt.#	UNIT PRICE	UNIT PRICE EXTENSION (Quantity times Unit Price)
REF. NO.	QUANTITY:	UNIT OF MEASURE:		
402-01-00100	180	Cu Yd.		

DESCRIPTION:	24" RCP DRIVEWAY PIPE REPLACEMENT	<input checked="" type="checkbox"/> Base Bid or <input type="checkbox"/> Alt.#	UNIT PRICE	UNIT PRICE EXTENSION (Quantity times Unit Price)
REF. NO.	QUANTITY:	UNIT OF MEASURE:		
701-03	1	Each		

All quantities are estimated. The contractor will be paid based upon actual quantities as verified by the Owner

LOUISIANA UNIFORM PUBLIC WORK BID FORM

UNIT PRICE FORM

TO: Jefferson Parish Purchasing Department
200 Derbigny Street, Suite 4400
Gretna, Louisiana 70053
ATTN: Purchasing
(Owner to provide name and address of owner)

BID FOR: River Road Waterline Replacement -- Phase 2
Williswood Lane to Rivet Blvd.
Public Works Project No. 2015-049-WR
Bid Proposal No. 50-00117630
(Owner to provide name of project and other identifying information)

UNIT PRICES: This form shall be used for any and all work required by the Bidding Documents and described as unit prices. Amounts shall be stated in figures and only in figures.

DESCRIPTION:	CONCRETE DRIVE (6" THICK) <input checked="" type="checkbox"/> Base Bid or <input type="checkbox"/> Alt.# _____	UNIT PRICE	UNIT PRICE EXTENSION (Quantity times Unit Price)
REF. NO.	QUANTITY:	UNIT OF MEASURE:	
706-02-00200	900	Sq. Yd.	

DESCRIPTION:	SLAB SODDING (ST. AUGUSTINE) <input checked="" type="checkbox"/> Base Bid or <input type="checkbox"/> Alt.# _____	UNIT PRICE	UNIT PRICE EXTENSION (Quantity times Unit Price)
REF. NO.	QUANTITY:	UNIT OF MEASURE:	
714-01-00600	2,600	Sq. Yd.	

DESCRIPTION:	SEEDING <input checked="" type="checkbox"/> Base Bid or <input type="checkbox"/> Alt.# _____	UNIT PRICE	UNIT PRICE EXTENSION (Quantity times Unit Price)
REF. NO.	QUANTITY:	UNIT OF MEASURE:	
717-01-00100	80	Lbs.	

DESCRIPTION:	MOBILIZATION <input checked="" type="checkbox"/> Base Bid or <input type="checkbox"/> Alt.# _____	UNIT PRICE	UNIT PRICE EXTENSION (Quantity times Unit Price)
REF. NO.	QUANTITY:	UNIT OF MEASURE:	
727-01-00100	1	Lump	

DESCRIPTION:	ADJUSTING WATER METER BOX <input checked="" type="checkbox"/> Base Bid or <input type="checkbox"/> Alt.# _____	UNIT PRICE	UNIT PRICE EXTENSION (Quantity times Unit Price)
REF. NO.	QUANTITY:	UNIT OF MEASURE:	
741-11-00200	30	Each	

DESCRIPTION:	MAINTENANCE OF TRAFFIC, SIGNS AND BARRICADES <input checked="" type="checkbox"/> Base Bid or <input type="checkbox"/> Alt.# _____	UNIT PRICE	UNIT PRICE EXTENSION (Quantity times Unit Price)
REF. NO.	QUANTITY:	UNIT OF MEASURE:	
NS-MNT-20032	1	Lump	

DESCRIPTION:	EXPLORATORY EXCAVATION <input checked="" type="checkbox"/> Base Bid or <input type="checkbox"/> Alt.# _____	UNIT PRICE	UNIT PRICE EXTENSION (Quantity times Unit Price)
REF. NO.	QUANTITY:	UNIT OF MEASURE:	
S-002	40	Each	

All quantities are estimated. The contractor will be paid based upon actual quantities as verified by the Owner

LOUISIANA UNIFORM PUBLIC WORK BID FORM

UNIT PRICE FORM

TO: Jefferson Parish Purchasing Department
200 Derbigny Street, Suite 4400
Gretna, Louisiana 70053
ATTN: Purchasing
(Owner to provide name and address of owner)

BID FOR: River Road Waterline Replacement – Phase 2
Williswood Lane to Rivet Blvd.
Public Works Project No. 2015-049-WR
Bid Proposal No. 50-00117630
(Owner to provide name of project and other identifying information)

UNIT PRICES: This form shall be used for any and all work required by the Bidding Documents and described as unit prices. Amounts shall be stated in figures and only in figures.

DESCRIPTION:	TEMPORARY DRIVEWAY RAMP	Base Bid or <input type="checkbox"/> Alt. #	UNIT PRICE	UNIT PRICE EXTENSION (Quantity times Unit Price)
REF. NO.	QUANTITY:	UNIT OF MEASURE:		
S-003	30	Each		

DESCRIPTION:	ASPHALT PATCHING	Base Bid or <input type="checkbox"/> Alt. #	UNIT PRICE	UNIT PRICE EXTENSION (Quantity times Unit Price)
REF. NO.	QUANTITY:	UNIT OF MEASURE:		
S-004	360	Sq. Yd.		

DESCRIPTION:	GRIND EXISTING STUMPS	Base Bid or <input type="checkbox"/> Alt. #	UNIT PRICE	UNIT PRICE EXTENSION (Quantity times Unit Price)
REF. NO.	QUANTITY:	UNIT OF MEASURE:		
S-005	2	Each		

DESCRIPTION:	PROJECT SIGN	Base Bid or <input type="checkbox"/> Alt. #	UNIT PRICE	UNIT PRICE EXTENSION (Quantity times Unit Price)
REF. NO.	QUANTITY:	UNIT OF MEASURE:		
S-006	2	Each		

DESCRIPTION:	REMOVE AND REPLACE GRAVEL DRIVES	Base Bid or <input type="checkbox"/> Alt. #	UNIT PRICE	UNIT PRICE EXTENSION (Quantity times Unit Price)
REF. NO.	QUANTITY:	UNIT OF MEASURE:		
S-007	325	Sq. Yd.		

DESCRIPTION:	REMOVAL OF FIRE HYDRANTS	Base Bid or <input type="checkbox"/> Alt. #	UNIT PRICE	UNIT PRICE EXTENSION (Quantity times Unit Price)
REF. NO.	QUANTITY:	UNIT OF MEASURE:		
S-009	11	Each		

DESCRIPTION:	FENCE ANY KIND	Base Bid or <input type="checkbox"/> Alt. #	UNIT PRICE	UNIT PRICE EXTENSION (Quantity times Unit Price)
REF. NO.	QUANTITY:	UNIT OF MEASURE:		
S-010	500	Lin. Ft.		

DESCRIPTION:	WATER MAIN (6") (PVC C900)	Base Bid or <input type="checkbox"/> Alt. #	UNIT PRICE	UNIT PRICE EXTENSION (Quantity times Unit Price)
REF. NO.	QUANTITY:	UNIT OF MEASURE:		
W-106	20	Lin. Ft.		

All quantities are estimated. The contractor will be paid based upon actual quantities as verified by the Owner

Revised September 29, 2016 – Addendum No. 1

LOUISIANA UNIFORM PUBLIC WORK BID FORM

UNIT PRICE FORM

TO: Jefferson Parish Purchasing Department
 200 Derbigny Street, Suite 4400
 Gretna, Louisiana 70053
 ATTN: Purchasing
 (Owner to provide name and address of owner)

BID FOR: River Road Waterline Replacement – Phase 2
 Willswood Lane to Rivet Blvd.
 Public Works Project No. 2015-049-WR
 Bid Proposal No. 50-00117630
 (Owner to provide name of project and other identifying information)

UNIT PRICES: This form shall be used for any and all work required by the Bidding Documents and described as unit prices. Amounts shall be stated in figures and only in figures.

DESCRIPTION:	WATER MAIN (8") (PVC C900) <input type="checkbox"/> Base Bid or <input type="checkbox"/> Alt.#		UNIT PRICE	UNIT PRICE EXTENSION (Quantity times Unit Price)
REF. NO.	QUANTITY:	UNIT OF MEASURE:		
W-108	200	Lin. Ft.		
DESCRIPTION:	WATER MAIN (12") (PVC C900) <input type="checkbox"/> Base Bid or <input type="checkbox"/> Alt.#		UNIT PRICE	UNIT PRICE EXTENSION (Quantity times Unit Price)
REF. NO.	QUANTITY:	UNIT OF MEASURE:		
W-112	12,910	Lin. Ft.		
DESCRIPTION:	WATER MAIN (6") (DUCTILE IRON PIPE) <input checked="" type="checkbox"/> Base Bid or <input type="checkbox"/> Alt.#		UNIT PRICE	UNIT PRICE EXTENSION (Quantity times Unit Price)
REF. NO.	QUANTITY:	UNIT OF MEASURE:		
W-206	100	Lin. Ft.		
DESCRIPTION:	WATER MAIN (8") (DUCTILE IRON PIPE) <input checked="" type="checkbox"/> Base Bid or <input type="checkbox"/> Alt.#		UNIT PRICE	UNIT PRICE EXTENSION (Quantity times Unit Price)
REF. NO.	QUANTITY:	UNIT OF MEASURE:		
W-208	100	Lin. Ft.		
DESCRIPTION:	WATER MAIN (12") (DUCTILE IRON PIPE) <input checked="" type="checkbox"/> Base Bid or <input type="checkbox"/> Alt.#		UNIT PRICE	UNIT PRICE EXTENSION (Quantity times Unit Price)
REF. NO.	QUANTITY:	UNIT OF MEASURE:		
W-212	100	Lin. Ft.		
DESCRIPTION:	GATE VALVE AND VALVE BOX (6") <input checked="" type="checkbox"/> Base Bid or <input type="checkbox"/> Alt.#		UNIT PRICE	UNIT PRICE EXTENSION (Quantity times Unit Price)
REF. NO.	QUANTITY:	UNIT OF MEASURE:		
W-406	1	Each		
DESCRIPTION:	GATE VALVE AND VALVE BOX (8") <input checked="" type="checkbox"/> Base Bid or <input type="checkbox"/> Alt.#		UNIT PRICE	UNIT PRICE EXTENSION (Quantity times Unit Price)
REF. NO.	QUANTITY:	UNIT OF MEASURE:		
W-408	12	Each		
DESCRIPTION:	GATE VALVE AND VALVE BOX (12") <input checked="" type="checkbox"/> Base Bid or <input type="checkbox"/> Alt.#		UNIT PRICE	UNIT PRICE EXTENSION (Quantity times Unit Price)
REF. NO.	QUANTITY:	UNIT OF MEASURE:		
W-412	46	Each		

All quantities are estimated. The contractor will be paid based upon actual quantities as verified by the Owner

LOUISIANA UNIFORM PUBLIC WORK BID FORM

UNIT PRICE FORM

TO: Jefferson Parish Purchasing Department
 200 Derbigny Street, Suite 4400
 Gretna, Louisiana 70053
 ATTN: Purchasing
 (Owner to provide name and address of owner)

BID FOR: River Road Waterline Replacement – Phase 2
 Willswood Lane to Rivet Blvd.
 Public Works Project No. 2015-049-WR
 Bid Proposal No. 50-00117630
 (Owner to provide name of project and other identifying information)

UNIT PRICES: This form shall be used for any and all work required by the Bidding Documents and described as unit prices. Amounts shall be stated in figures and only in figures.

DESCRIPTION:	PIPE RESTRAINT (6") <input type="checkbox"/> Base Bid or <input type="checkbox"/> Alt.#	UNIT PRICE	UNIT PRICE EXTENSION (Quantity times Unit Price)
REF. NO.	QUANTITY:	UNIT OF MEASURE:	
W-706	2	Each	

DESCRIPTION:	PIPE RESTRAINT (8") <input type="checkbox"/> Base Bid or <input type="checkbox"/> Alt.#	UNIT PRICE	UNIT PRICE EXTENSION (Quantity times Unit Price)
REF. NO.	QUANTITY:	UNIT OF MEASURE:	
W-708	22	Each	

DESCRIPTION:	PIPE RESTRAINT (12") <input type="checkbox"/> Base Bid or <input type="checkbox"/> Alt.#	UNIT PRICE	UNIT PRICE EXTENSION (Quantity times Unit Price)
REF. NO.	QUANTITY:	UNIT OF MEASURE:	
W-712	75	Each	

DESCRIPTION:	TRANSITIONAL COUPLING (6") <input type="checkbox"/> Base Bid or <input type="checkbox"/> Alt.#	UNIT PRICE	UNIT PRICE EXTENSION (Quantity times Unit Price)
REF. NO.	QUANTITY:	UNIT OF MEASURE:	
W-806	1	Each	

DESCRIPTION:	TRANSITIONAL COUPLING (8") <input type="checkbox"/> Base Bid or <input type="checkbox"/> Alt.#	UNIT PRICE	UNIT PRICE EXTENSION (Quantity times Unit Price)
REF. NO.	QUANTITY:	UNIT OF MEASURE:	
W-807	13	Each	

DESCRIPTION:	TRANSITIONAL COUPLING (12") <input type="checkbox"/> Base Bid or <input type="checkbox"/> Alt.#	UNIT PRICE	UNIT PRICE EXTENSION (Quantity times Unit Price)
REF. NO.	QUANTITY:	UNIT OF MEASURE:	
W-810	3	Each	

DESCRIPTION:	DUCTILE IRON FITTINGS <input type="checkbox"/> Base Bid or <input type="checkbox"/> Alt.#	UNIT PRICE	UNIT PRICE EXTENSION (Quantity times Unit Price)
REF. NO.	QUANTITY:	UNIT OF MEASURE:	
W-901	7,500	Lbs.	

DESCRIPTION:	FIRE HYDRANT ASSEMBLY <input type="checkbox"/> Base Bid or <input type="checkbox"/> Alt.#	UNIT PRICE	UNIT PRICE EXTENSION (Quantity times Unit Price)
REF. NO.	QUANTITY:	UNIT OF MEASURE:	
W-902-A	27	Each	

All quantities are estimated. The contractor will be paid based upon actual quantities as verified by the Owner

LOUISIANA UNIFORM PUBLIC WORK BID FORM

UNIT PRICE FORM

TO: Jefferson Parish Purchasing Department
200 Derbigny Street, Suite 4400
Gretna, Louisiana 70053
ATTN: Purchasing
(Owner to provide name and address of owner)

BID FOR: River Road Waterline Replacement -- Phase 2
Williswood Lane to Rivet Blvd.
Public Works Project No. 2015-049-WR
Bid Proposal No. 50-00117630
(Owner to provide name of project and other identifying information)

UNIT PRICES: This form shall be used for any and all work required by the Bidding Documents and described as unit prices. Amounts shall be stated in figures and only in figures.

DESCRIPTION:	WATER SERVICE CONNECTION (<1")	<input checked="" type="checkbox"/> Base Bid or <input type="checkbox"/> Alt.#	UNIT PRICE	UNIT PRICE EXTENSION (Quantity times Unit Price)
REF. NO.	QUANTITY:	UNIT OF MEASURE:		
W-903-0	20	Each		

DESCRIPTION:	WATER SERVICE CONNECTION (1")	<input checked="" type="checkbox"/> Base Bid or <input type="checkbox"/> Alt.#	UNIT PRICE	UNIT PRICE EXTENSION (Quantity times Unit Price)
REF. NO.	QUANTITY:	UNIT OF MEASURE:		
W-903-1	10	Each		

DESCRIPTION:	WATER SERVICE CONNECTION (UP TO 2" POLYETHYLENE)	<input checked="" type="checkbox"/> Base Bid or <input type="checkbox"/> Alt.#	UNIT PRICE	UNIT PRICE EXTENSION (Quantity times Unit Price)
REF. NO.	QUANTITY:	UNIT OF MEASURE:		
W-903-2	10	Each		

DESCRIPTION:	ABANDONMENT OF WATERLINE (8")	<input checked="" type="checkbox"/> Base Bid or <input type="checkbox"/> Alt.#	UNIT PRICE	UNIT PRICE EXTENSION (Quantity times Unit Price)
REF. NO.	QUANTITY:	UNIT OF MEASURE:		
W-908	12,910	Lin. Ft.		

DESCRIPTION:	REMOVAL AND DISPOSAL OF AC WATERLINE (6")	<input checked="" type="checkbox"/> Base Bid or <input type="checkbox"/> Alt.#	UNIT PRICE	UNIT PRICE EXTENSION (Quantity times Unit Price)
REF. NO.	QUANTITY:	UNIT OF MEASURE:		
W-907-6	200	Lin. Ft.		

DESCRIPTION:	REMOVAL AND DISPOSAL OF AC WATERLINE (8")	<input checked="" type="checkbox"/> Base Bid or <input type="checkbox"/> Alt.#	UNIT PRICE	UNIT PRICE EXTENSION (Quantity times Unit Price)
REF. NO.	QUANTITY:	UNIT OF MEASURE:		
W-907-8	200	Lin. Ft.		

DESCRIPTION:	HANDICAPPED CURB RAMP	<input checked="" type="checkbox"/> Base Bid or <input type="checkbox"/> Alt.#	UNIT PRICE	UNIT PRICE EXTENSION (Quantity times Unit Price)
REF. NO.	QUANTITY:	UNIT OF MEASURE:		
706-04-00100	4	Each		

DESCRIPTION:	AIR RELEASE VALVE WITH MANHOLE	<input checked="" type="checkbox"/> Base Bid or <input type="checkbox"/> Alt.#	UNIT PRICE	UNIT PRICE EXTENSION (Quantity times Unit Price)
REF. NO.	QUANTITY:	UNIT OF MEASURE:		
NS-P55-23500	5	Each		

All quantities are estimated. The contractor will be paid based upon actual quantities as verified by the Owner

LOUISIANA UNIFORM PUBLIC WORK BID FORM

UNIT PRICE FORM

TO: Jefferson Parish Purchasing Department
 200 Derbigny Street, Suite 4400
 Gretna, Louisiana 70053
 ATTN: Purchasing
 (Owner to provide name and address of owner)

BID FOR: River Road Waterline Replacement – Phase 2
 Willwood Lane to Rivet Blvd.
 Public Works Project No. 2015-049-WR
 Bid Proposal No. 50-00117630
 (Owner to provide name of project and other identifying information)

UNIT PRICES: This form shall be used for any and all work required by the Bidding Documents and described as unit prices. Amounts shall be stated in figures and only in figures.

DESCRIPTION:	REMOVAL OF PORTLAND CEMENT CONCRETE PAVEMENT	<input checked="" type="checkbox"/> Base Bid or <input type="checkbox"/> Alt.#	UNIT PRICE	UNIT PRICE EXTENSION (Quantity times Unit Price)
REF. NO.	QUANTITY:	UNIT OF MEASURE:		
202-02-02021	700	Sq. Yd.		
DESCRIPTION:	REMOVE CONCRETE WALK	<input checked="" type="checkbox"/> Base Bid or <input type="checkbox"/> Alt.#	UNIT PRICE	UNIT PRICE EXTENSION (Quantity times Unit Price)
REF. NO.	QUANTITY:	UNIT OF MEASURE:		
202-02-06200	150	Sq. Yd.		
DESCRIPTION:	PORTLAND CEMENT CONCRETE (9" THICK)	<input checked="" type="checkbox"/> Base Bid or <input type="checkbox"/> Alt.#	UNIT PRICE	UNIT PRICE EXTENSION (Quantity times Unit Price)
REF. NO.	QUANTITY:	UNIT OF MEASURE:		
601-01-00300	700	Sq. Yd.		
DESCRIPTION:	CONCRETE WALK (4" THICK)	<input checked="" type="checkbox"/> Base Bid or <input type="checkbox"/> Alt.#	UNIT PRICE	UNIT PRICE EXTENSION (Quantity times Unit Price)
REF. NO.	QUANTITY:	UNIT OF MEASURE:		
706-01-00100	150	Sq. Yd.		
DESCRIPTION:	REMOVE AND REPLACE CONCRETE CURB	<input checked="" type="checkbox"/> Base Bid or <input type="checkbox"/> Alt.#	UNIT PRICE	UNIT PRICE EXTENSION (Quantity times Unit Price)
REF. NO.	QUANTITY:	UNIT OF MEASURE:		
707-01-00100	500	Lin. Ft.		

All quantities are estimated. The contractor will be paid based upon actual quantities as verified by the Owner



Bid Proposal No.50-00117630
Addendum No. 1

JEFFERSON PARISH

Department of Purchasing

Michael S. Yenni
Parish President

Brenda J. Campos
Director

CHANGES TO JEFFERSON PARISH BIDDING PROCEDURES

Bidders should carefully read and must respond accordingly per the requirements of the bid packages. Bidders should reference the "Additional Requirements" section of the bid instructions and/or the "Important Notice to Bidders" included in the bid package for specific requirements to respond accordingly.

Effective August 1, 2016, please be advised:

- Affidavits (Non-Public Works Affidavit or Public Works Affidavit) – as you are aware, bidders are required to submit affidavits pursuant to LA public bid law and Jefferson Parish Code of Ordinances. Bidders must read each bid package to ensure compliance. Effective August 1st, ***affidavits are required with bid submission***. While copies are acceptable to include with bid submission, original affidavits are required upon contract execution. Original affidavits are encouraged with bid submission.
- Current W9 Forms and vendor applications may be submitted at any time; however, if your company is not registered and/or a current W-9 form is not on file, a current W-9 form must be supplied upon contract execution, should you be awarded a contract and/or issued a purchase order.
- Upon contract execution, successful bidder must continue producing final insurance certificates per standard Jefferson Parish insurance requirements. Proof of insurance is required for bidding purposes. Bidders must read the insurance requirements attachment included in each bid package for specific instructions.

These changes are pursuant Louisiana Public Bid Law more specifically, Act 406 of the 2016 Louisiana Legislative Regular Session. For the purposes of this communication, this change applies to Jefferson Parish Government bid solicitations only. For more information, please call Jefferson Parish Purchasing at 504-364-2678.



Bid Proposal No. 50-00117630
Addendum No. 1

DEPARTMENT OF THE ARMY
CORPS OF ENGINEERS, NEW ORLEANS DISTRICT
P. O. BOX 60267
NEW ORLEANS, LA 70160-0267

September 15, 2016

REPLY TO
ATTENTION OF

Operations Division
Operations Manager
Completed Works

Mr. John Monzon P.E., M.ASCE - Regional Director
Southeast Louisiana Flood Protection Authority - West
West Jefferson Levee District
7001 River Road
Marrero, Louisiana 70072

Dear Mr. Monzon:

We have received a letter request, dated May 11, 2016, from Digital Engineering, Inc., on behalf of Jefferson Parish Department of Water, concerning permission to replace 13,100 linear feet of a water line from Willswood Lane to Rivet Boulevard landward of the right descending Mississippi River levee, between second order levee stations 120+00 and 257+00, at Westwego, Louisiana, in Jefferson Parish.

We have no objection to your Office's issuance of a permit for the proposed work provided:

a. The work is accomplished in accordance with the above referenced letter and accompanying drawings.

b. All drilling work is performed and completed while the stage of the Mississippi River is below elevation +11.0 feet on the Carrollton gage, at New Orleans, Louisiana. Information concerning current river stages may be obtained on our website at www.mvn.usace.army.mil.

c. Drilling fluid is not allowed in the directional drilling process.

d. All excavation work is performed and backfilled while the stage of the Mississippi River is below elevation +11.0 feet on the Carrollton gage, at New Orleans, Louisiana.

e. All open excavations need to be backfilled to natural ground prior to the river stage rising to +11.0 feet on the Carrollton gage, at New Orleans, Louisiana.

Bid Proposal No. 50-00117630
Addendum No. 1

-2-


d. The applicant must provide written notification to this office of the construction timeline to include the proposed start and end dates. Additionally, the applicant must notify this office prior to commencement and upon completion of the work permitted herein.

This letter of no objection is based upon engineering criteria, and no interpretation or comments regarding local laws, zoning, or ordinances concerning property rights, etc., have been made. Additionally, this letter of no objection does not obviate the applicant's requirement to obtain federal, state, or local permits required by law, and no work should commence until all necessary permits are required.

If you have any questions, please contact me or Mayra Flores of my office at 504-862-2241 or 504-862-2459, respectively. Additionally, future correspondence concerning this project should reference our Letter of No Objection number 16-503. This will allow us to more easily locate records of previous correspondence, and thus provide a quicker response.

Please furnish this office a copy of your permit if the applicant's proposal is approved by your Office.

Sincerely,

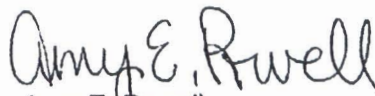

Amy E. Powell
Operations Manager, Completed Works

cc:

CPRA
Digital Engineering
Attn: Robert J. Delaune

IMPORTANT NOTICE TO ALL BIDDERS – BID REQUIREMENTS

Vendors may submit electronic bids with no fee for submission by using Central Auction House. Vendors may visit www.purchasing.jeffparish.net for further information and for link to Central Auction House or visit them directly at www.jeffparishbids.net. By submitting a bid, vendor agrees to comply with all provisions of Louisiana Law as well as compliance with the Jefferson Parish Code of Ordinances, Louisiana Code of Ethics, as published on <http://ethics.la.gov> and applicable Jefferson Parish ethical standards.

As per LA R.S. 38:2212(B)(2), the bid form shall contain Bid Security or Bid Bond, Acknowledgment of Addenda, Base Bid, Alternates, Signature of Bidder, Name, Title and Address of Bidder, Name of Firm or Joint Venture Corporate Resolution or other appropriate signature authorization, if required, Louisiana Contractors License Number, and on public works projects where unit prices are utilized, a section on the bid form where the unit price utilized in the bid shall be set forth; however, unit prices shall not be utilized for the construction of building projects, unless the unit price is incorporated into the base bid or alternates.

Pursuant to LA R.S. 28:2212(B)(3)(b), all bidders bidding on public works for Jefferson Parish shall submit all bid forms as required by statute or by LA Administrative Code to the governing authority of Jefferson Parish or by Jefferson Parish Code of Ordinances and the Jefferson Parish General Terms and Conditions with bid submission. Failure to provide said information and documentation with bid submission shall be grounds to declare the bid non-responsive. This required information and documentation includes, but is not limited to, the Public Works Bid Affidavit and current insurance certificate. For bidding purposes, all bidders must submit with bid submission completed, signed and properly notarized affidavits, including: Non-Conviction Affidavit, Non-Collusion Affidavit, Campaign Contribution Affidavit, Debt Disclosures Affidavit and E-Verify Affidavit. For the convenience of vendors, all affidavits have been combined into one form entitled PUBLIC WORKS BID AFFIDAVIT, which is included in this bid package. This affidavit must be submitted in its original format, and without material alteration, in order to be compliant and for the bid to be considered responsive. A scanned copy of the completed, signed and properly notarized affidavit may be submitted with the bid; however, the successful bidder must submit the original affidavit in its original format and without material alteration upon contract execution. Failure to comply will result in the bid submission being rejected as non-responsive. The Parish reserves the right to award bid to the next lowest responsive and responsible bidder in this event.

Bidders must review the bid specifications and include any other required documentation as appropriate, especially if federal funding regulations and requirements apply. Please note that the payment and performance bonds must be supplied by the successful bidder upon contract signing. Further, while Jefferson Parish may have these on file, all bidders are encouraged to furnish their current W-9 Form and respective Tax Identification Numbers with bid submission; records on file may be invalid or expired. However, the successful bidder must submit a W-9 Form and respective Tax Identification Number upon contract execution. Failure to do so may result in payment delays.

Louisiana Contractor's License shall be in the following category:

Municipal and Public Works Construction

Probable Construction Cost: \$ 1,885,700.00

Bidder agrees that this bid shall be good and may not be withdrawn for a period of forty-five (45) calendar days after the scheduled closing time for receiving bids. In the event the Owner issues the Letter of Award (copy of adopted resolution awarding bid by Jefferson Parish Council) during this period, the bid accepted shall continue to remain binding until the execution of the Contract.

Bid Proposal No. 50-00117630
Addendum No. 1

Low Bidder will execute the formal agreement and will deliver a Performance Bond or Bonds for the faithful performance of the Contract.

Bid Security, in the sum of five percent (5%) of the total bid price (Base Bid and any Alternates), is to become the property of the Owner in the event the successful bidder fails or refuses to execute the Contract or fails to produce performance and payment bonds upon contract signing. If submitting a bid online, vendors must submit an electronic bid bond through the respective online clearinghouse bond management system(s) as indicated in the electronic bid Solicitation on Central Auction House. No scanned paper copies of any bid bond will be accepted as part of the electronic bid submission.

Further, upon receiving a notice to proceed, the Bidder agrees that all work shall be completed as follows: Within 180 calendar days of Notice to Proceed

Further, as per Resolutions 113646 and 113647, the Bidder agrees to pay, as liquidated damages, the sum of \$500.00 as follows for: (1) each consecutive calendar day after the agreed date of completion that the work remains substantially incomplete, or (2) each consecutive calendar day after substantial completion that the work has not been finally completed.

In addition to and not in lieu of the per diem liquidated damages, Owner shall also be entitled to recover from Contractor or Contractor's Surety additional liquidated damages as detailed in Resolutions 113646 and 113647. These additional liquidated damages may include, but are not limited to the following, in the amounts and for each of the items identified in the Supplementary Conditions:

- (1) Extended architectural and/or engineering fees \$ 265.00 ;
- (2) Extended Resident Project Representative fees \$ 520.00 ;
- (3) Extended construction management fees \$ 322.00 ;
- (4) Extended Owner's overhead and personnel expenses \$ 265.00 ; and
- (5) Owner's other costs directly related to the delay in completion beyond the Contract Times.

In addition to liquidated damages, in accordance with Section 6.02, "Labor; Working Hours," whenever Contractor's work requires inspections in excess of the budgeted amount for inspection, Contractor shall reimburse Owner for the additional costs incurred by the Owner with respect to inspection of the contracted project provided the additional costs for inspections are above the budgeted amount for the contracted project.

For this project, the Project Representative Services, in accordance with the terms of the Engineer's agreement with the Owner, provides that the average hourly rate to be charged for resident inspection for this construction project is \$ 65.00 and the reasonable budget for such inspections is \$ 90,000.00 (the overtime rates shall be \$ 78.00 per hour). The cost of inspection in excess of this budgeted amount shall be assessed against Contractor's progress payments, all in accordance with LSA R.S. 38:2216(L)(2).

It shall be the duty of every parish officer, employee, department, agency, special district, board, and commission; and the duty of every contractor, subcontractor, and licensee of the parish, and the duty of every applicant for certification of eligibility for a parish contract or program, to cooperate with the inspector general in any investigation, audit, inspection, performance review, or hearing pursuant to this chapter. Every parish contract and every bid, proposal, application or solicitation for a parish contract, and every application for certification of eligibility for a parish contract or program shall contain a statement that the corporation, partnership, or person understands and will abide by all provisions of this chapter.


River Rd. Waterline Replacement Phase 2
Rivet Blvd. to Willswood Lane
Project No. 2015-049-WR
Bid Proposal No. 50-00117630
Plan Holders List

Command Construction, LLC
3606 N. Turnbull Drive
Metairie, LA 70002


Construct Connect
30 Technology Parkway South
Suite 100
Norcross, GA 30092

ROADWAY RESTORATION


NOTE

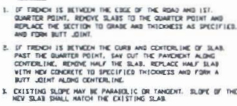


D. REPLACEMENT OF HALF PANEL SLABS

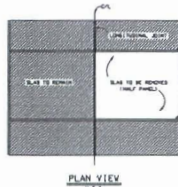


NOTES-4 (CONT.)

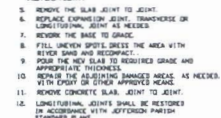

GENERAL:

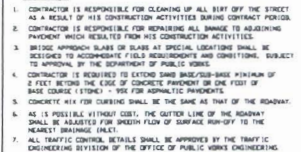

ASPHALT ROADWAY

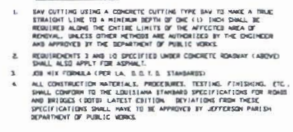


NOTES:
THIS TYPICAL ROADWAY RESTORATION PLAN WILL BE IN CONJUNCTION WITH
THE FOLLOWING:




NOTES

1. SHALLOW TO STREET CROWNED BY CONTRACTOR'S OPERATIONS BEYOND PAY LIMITS SHALL BE REMOVED AND REPLACED AT NO ADDITIONAL COST TO THE OWNER.
2. IF LESS THAN 2" FROM EDGE OF CUT TO EDGE OF ROAD, REMOVE ALL ROAD FROM WITHIN THE STRIP AND INCLUDE IN THE PAY WITHIN.
3. CONTRACTOR SHALL BACKFILL WITH BASE MATERIAL AND 4" OF ASPHALT BINDER COURSE TO EXISTING GRADE AND MAINTAIN AREA AS A RIDING SURFACE FOR A MINIMUM OF ONE MONTH OR AS DIRECTED BY THE ENGINEER AND APPROVED BY THE OWNER. WHEN THE EXISTING SURFACE IS NOT MECHANICALLY COMPACTED, SHALL BE REMOVED FROM TRENCH AND EXPOSED SURFACE MECHANICALLY COMPACTED TO REDESIGN COMPACT RATIO TO ASPHALT PLACEMENT.
4. WEARING COURSE MAY BE USED AS A BINDER BUT NOT VICE-VERSA.


[illegible]

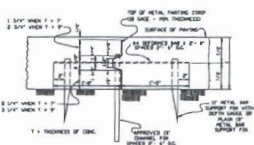


DEFORMED LONGITUDINAL JOINT
(ALSO CALLED METAL KEYED JOINT)
N.T.S.

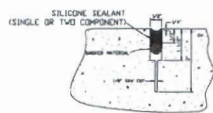

DETAIL "A"
DETAIL "A" AND "B" ARE USED IN CONNECTION WITH TRANSVERSE BUTT JOINT ON TYPICAL JOINT

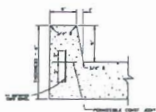


6' HIGH BARRIER TYPE CONCRETE CURB
(CONCRETE PAVEMENT ROADWAY)
N.T.S.

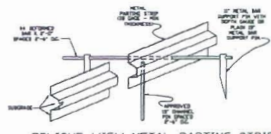

OBLIQUE VIEW METAL PARTING STRIP FOR DEFORMED LONGITUDINAL JOINT
N.T.S.


NOTE: ALL JOINTS FOR CONCRETE PAVEMENT SHOWN IN L.A. S.D.E.S. STANDARD PLANS (CP-4) CAN BE USED AT THE DISCRETION OF THE ENGINEER WHO SHALL PROVIDE CONSTRUCTION DETAILS TO CONSTRUCTION

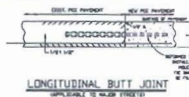


LONGITUDINAL BUTT JOINT
(CONCRETE PAVEMENT ROADWAY)
N.T.S.




TRANSVERSE BUTT JOINT
(CONCRETE PAVEMENT ROADWAY)
N.T.S.

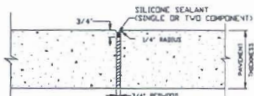


EXPANSION JOINT
(FOR CONCRETE SIDEWALK & RAMP FOR TRANSPIRABLE)
N.T.S.

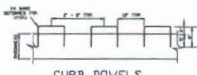


CURB DOWELS
N.T.S.

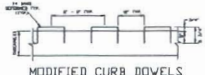


MODIFIED CURB DOWELS
(USED ON MODIFIED BARRIER CURB)
N.T.S.

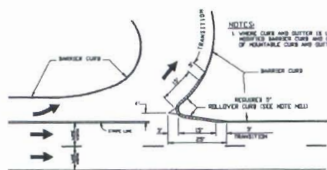


ROLLOVER CURB IN THE GORE AREA
(2-1/2" TURN LANE OR HIGHWAY SPLIT)
N.T.S.

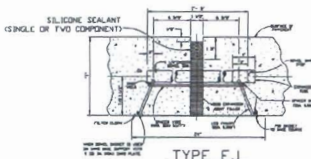


TYPE E JOINT
(CONCRETE PAVEMENT ROADWAY)
N.T.S.

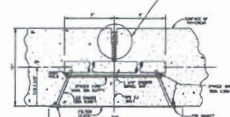


TYPE D OR C JOINT
(CONCRETE PAVEMENT ROADWAY)
N.T.S.

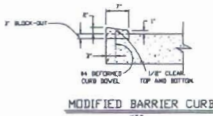


MODIFIED BARRIER CURB
N.T.S.

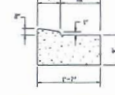

MODIFIED BARRIER CURB AND GUTTER
N.T.S.

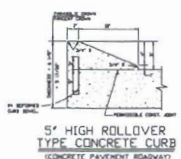

5' HIGH ROLLOVER TYPE CONCRETE CURB
(CONCRETE PAVEMENT ROADWAY)
N.T.S.

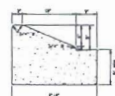

5' HIGH ROLLOVER TYPE CONCRETE CURB
(ASPHALT PAVEMENT ROADWAY)
N.T.S.



8' HIGH BARRIER TYPE CONCRETE CURB & GUTTER
(ASPHALT PAVEMENT ROADWAY)
N.T.S.



6' HIGH BARRIER TYPE CONCRETE CURB & GUTTER
(ASPHALT PAVEMENT ROADWAY)
N.T.S.

Bid No.: 50-00117630
Addendum No. 1

JEFFERSON PARISH DEPARTMENT OF ENGINEERING			
TYPICAL ROADWAY DETAILS			
DESIGNED BY	C.E. WILSON	DATE	08/08/08
DESIGNED BY	C.E. WILSON	DATE	08/08/08
SHT. 1 OF 1


JEFFERSON PARISH
DEPARTMENT OF ENGINEERING

STANDARD RESIDENTIAL DETAILS FOR CONNECTING
 DRIVEWAYS TO EXISTING ROADWAYS

DATE	BY	CHKD BY	DATE
C.S.	06/11/04	H.J.V.	07/29/04
C.S.	06/09/07	P.S.	08/29/07
J.L.	06/12/07	V.V.	06/18/07
J.L.	03/12/08	P.S.	05/12/08


PROJECT NO. **AUTOCAD 2508** SHEET NO. **RESIDENTIAL DRIVEWAYS**

FILE NUMBER **ENV-09** SHEET NO. **1 OF 1**

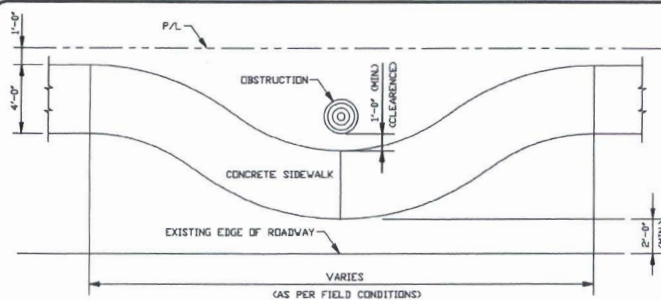


TYPICAL DETAIL FOR GOING AROUND
SIDEWALK OBSTRUCTION
(N.T.S.)

①	②
1'	5/8"
2'	1 1/4"
3'	1 7/8"
4'	2 1/4"
5'	3 1/8"
6'	3 3/4"
7'	4 3/8"

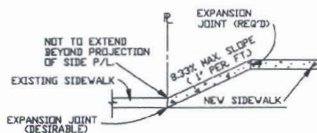

ELEVATION VIEW "A" OF TRANSITION FROM
NEW SIDEWALK TO EXISTING SIDEWALK
(N.T.S.)
(SEE SPEC. NO.11)

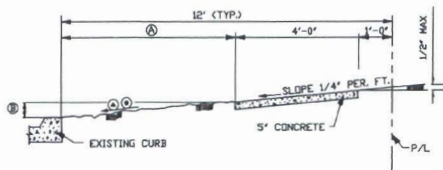

TYPICAL SECTION
(STREET WITH CURB)
(N.T.S.)

- ① THE TYPICAL STANDARD SLOPE WITHIN ① IS 5.2% (5/8" PER FOOT). THE MAXIMUM ALLOWABLE SLOPE WITHIN ① IS 7.3% (7/8" PER FOOT) IN THE VICINITY OF AREAS ADJACENT TO EXISTING OR PROPOSED DRIVEWAYS. ANY SLOPE WITHIN ① GREATER THAN THE TYPICAL STANDARD SLOPE OF 5.2% (5/8" PER FOOT) MUST BE APPROVED IN WRITING BY MR. ERROL MARTIN, JR., ENGINEERING DIVISION SUPERVISOR, AT 564-736-6793 PRIOR TO CONSTRUCTION.
- ② DRIVEWAYS MUST BE DESIGNED AND CONSTRUCTED TO PROVIDE FOR A MAXIMUM LONGITUDINAL SIDEWALK SLOPE OF 8.33% (1" PER FOOT), WHICH INCLUDES THE LONGITUDINAL TRANSITION FROM NEW SIDEWALK TO EXISTING SIDEWALK LOCATED AT THE ADJACENT PROPERTY LINE.

* RESIDENTIAL SIDEWALK SPECIFICATIONS *


- CONTACT THE DEPARTMENT OF ENGINEERING AT (504)736-6793 PRIOR TO BEGINNING ANY SIDEWALK CONSTRUCTION. ANY DEVIATION FROM STANDARD DETAILS AND SPECIFICATIONS WILL NEED THE APPROVAL OF THE DIRECTOR OF ENGINEERING.
- ALL SIDEWALKS SHALL BE CONSTRUCTED OF PORTLAND CEMENT CONCRETE AND HAVE A COMPRESSIVE STRENGTH OF THREE THOUSAND (3000) POUNDS PER SQUARE INCH IN TWENTY- EIGHT DAYS.
- ALL (OPC) SIDEWALKS SHALL HAVE A MINIMUM THICKNESS OF FOUR (4) INCHES.
- ALL (OPC) SIDEWALKS SHALL BE CONSTRUCTED AT A DISTANCE OF ONE (1) FOOT FROM THE PROPERTY LINE UNLESS OTHERWISE ALLOWED BY THE DIRECTOR OF THE DEPARTMENT OF ENGINEERING.
- ALL (OPC) SIDEWALKS SHALL HAVE A MINIMUM WIDTH OF FOUR (4) FEET.
- ALL (OPC) SIDEWALKS SHALL BE SCORED AT FOUR (4) FOOT INTERVALS TO A DEPTH OF 3/4".
- ALL (OPC) SIDEWALK SHALL HAVE EXPANSION JOINTS NO FURTHER APART THAN TWENTY (20) FEET. EXPANSION JOINTS SHALL BE CONSTRUCTED OF THREE-FOURTH INCH THICK TREATED (ROT-RESISTANT) TIMBER, OR REDWOOD WITH MINIMUM OF FOUR #10 NAILS DRIVEN THROUGH EACH SIDE (SEE PERSPECTIVE 'B').
- ALL (OPC) EDGES SHALL BE TOOLED TO ONE-FOURTH (1/4) INCH RADIUS.
- NO OBSTRUCTIONS OR OPEN GRATES FOR DRAIN LINES WILL BE ALLOWED IN SIDE WALK. (SEE DETAIL FOR GOING AROUND OBSTRUCTIONS.)
- HANDICAPPED RAMPS AT CORNERS WILL BE CONSTRUCTED WITH DETECTABLE WARNINGS CONSISTING OF TRUNCATED DOMES. (SEE TYPICAL DETAILS.)
- TRANSITION RAMPS CONSTRUCTED WHERE NEW SIDEWALK MEETS EXISTING SIDEWALK SHALL HAVE A MAXIMUM SLOPE OF 8.33% (1" DROP EVERY 12"). SUCH RAMPS SHALL NOT EXTEND BEYOND THE PROJECTED SIDE PROPERTY LINES AND SHALL HAVE AN EXPANSION JOINT AT TOP OF SLOPE. PLACE EXPANSION JOINT AT BOTTOM OF SLOPE IF POSSIBLE (SEE ELEVATION VIEW 'A').

Bid No.: 50-00117630
Addendum No. 1

JEFFERSON PARISH DEPARTMENT OF ENGINEERING			
STANDARD RESIDENTIAL SIDEWALK DETAILS			
DESIGNED BY	C.S.	DATE	06/11/84
CHECKED BY	C.S.	DATE	06/19/87
DESIGNED BY	J.L.	DATE	06/11/87
CHECKED BY	J.L.	DATE	06/19/87
DESIGNED BY	J.L.	DATE	05/12/88
CHECKED BY	J.L.	DATE	05/12/88
AUTOCAD L.T. 8804			
ENV-09			
SHEET NO. 1 OF 2			


HAND TOoled CONTRACTION JOINT
(MAXIMUM SPACING = 4'-0")
SCALE: 1" = 1'

SAWED CONTRACTION JOINT
MAXIMUM SPACING = 4'-0"

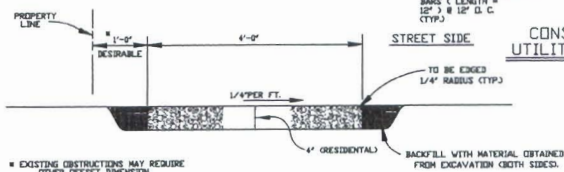


SECTION 'A-A'


N.T.S.

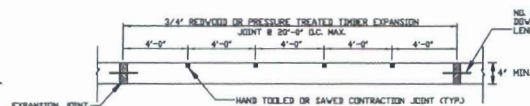


ELEVATION VIEW OF SIDEWALK

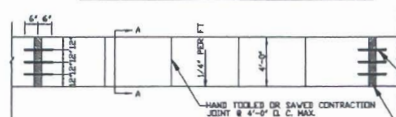

PLAN VIEW OF SIDEWALK

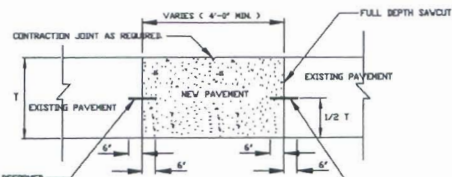


CONSTRUCTION JOINT DETAIL FOR
UTILITY CUTS AND/OR REPAIR SECTION

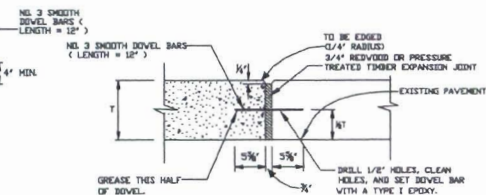


EXPANSION JOINT (TYPE 'B')

(MAXIMUM SPACING = 20'-0")

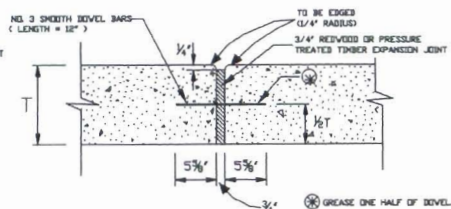


EXPANSION JOINT (TYPE 'A')



(MAXIMUM SPACING = 20'-0")

 JEFFERSON PARISH DEPARTMENT OF ENGINEERING	
STANDARD RESIDENTIAL SIDEWALK DETAILS	
DESIGNED BY C-S	DATE 06/13/94
CHECKED BY H-L.V.	DATE 07/29/94
DESIGNED BY P.S.	DATE 02/29/97
CHECKED BY H.L.	DATE 06/03/97
DESIGNED BY J.L.	DATE 03/12/98
CHECKED BY J.L.	DATE 03/18/98
AUTOCAD LT. 2004	
RESIDENTIAL SIDEWALK 2X30	
EX-99	
SHEET NO. 2 OF 2	


Bid No.: 50-00117630
Addendum No. 1

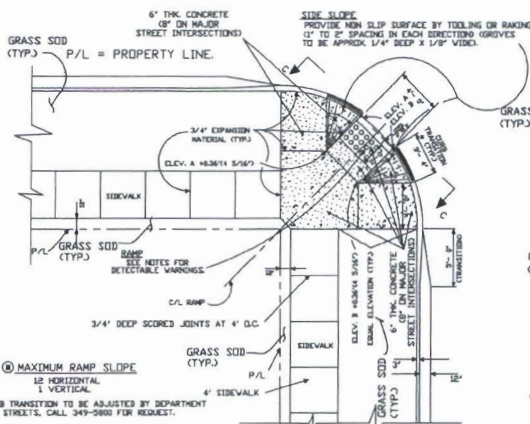


PLAN OF TYPICAL SIDEWALK
WITH RAMP FOR HANDICAPPED
N.T.S.

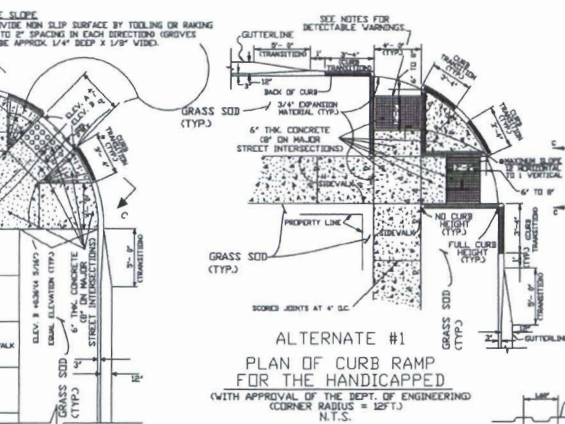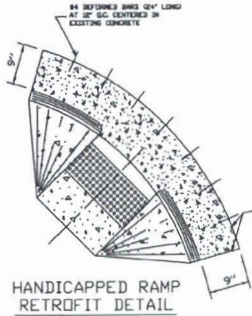


ALTERNATE #1
PLAN OF CURB RAMP
FOR THE HANDICAPPED
(WITH APPROVAL OF THE DEPT. OF ENGINEERING
CORNER RADIUS = 12 FT.)
N.T.S.

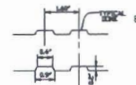

SECTION THRU TRUNCATED DOMES
ON WALKING SURFACES 05/06/02
N.T.S.

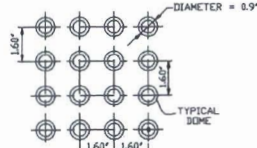

PARTIAL PLAN OF TRUNCATED DOMES
ON WALKING SURFACES 05/06/02
(N.T.S.)

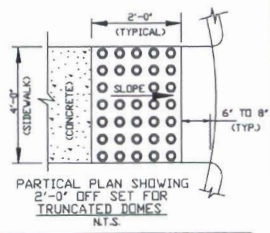


PARTIAL PLAN SHOWING
2'-0\"/>

JEFFERSON PARISH DEPARTMENT OF ENGINEERING			
STANDARD RESIDENTIAL DETAILS FOR CONNECTING HANDICAPPED RAMPS TO EXISTING ROADWAYS			
REVISION	DATE	BY	DATE
C.S.	06/11/04	H.L.V.	07/29/04
C.S.	02/09/07	P.S.	02/09/07
J.L.	06/08/07	P.S.	06/08/07
J.L.	05/12/08	P.S.	05/12/08
J.V.	07/28/14	C.S.	10/08/10
C.S.	05/24/10	C.S.	05/24/10
AUTOCAD 2000/11/2000		RESIDENTIAL HANDICAPPED RAMPS	
REV 0000		ENV-29	


Bid No.: 50-00117630 - Addendum No. 1

SHEET NO. 1 OF 1

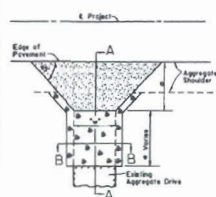


TYPE "A"

Paved Drive Along Aggregate Shoulder

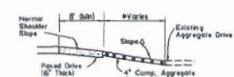

SECTION A-A

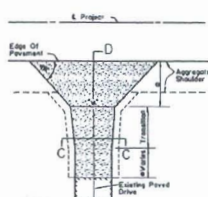


TYPE "B"

Paved Drive Along Aggregate Shoulder Correction Existing Paved Drive




SECTION B-B

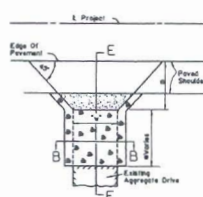


TYPE "C"

Paved Drive Along

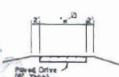


SECTION C-C

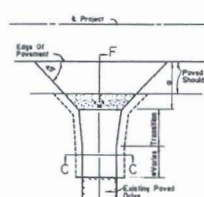


TYPE "D"

Paved Drive Along Paved Shoulder
Connecting Exit to Round Drive

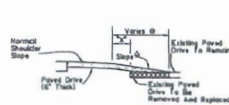


SECTION D-D

NOTE: If "X" is Greater Than 8', Aggregate Surface Course To Be Used Within

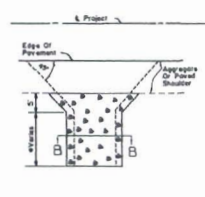


TYPE "E"

Aggregate Surface Course Drive To Be Used At Locations Where Drive Does Not Connect To Residence Or Commercial Establishment

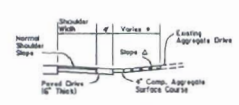

SECTION E-E

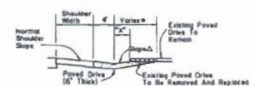

SECTION F-F

NOTE: If "X" is Greater Than 4', Aggregate Surface Course To Be Used Within Limits Of "X" Dimension.

- SEE PLANS
 60"W" = Width as per plans

NOTES

- a. FOR LANE ELEMENT CONCRETE DRIVES WILL BE CONSTRUCTED ONLY TO REPLACE OR EXISTING CONCRETE DRIVES. ALL OTHER DRIVES ARE TO BE ASPHALTIC CONCRETE, EXCEPT ASIGRATED SURFACE COURSE OR SPECIAL ESTABLISHMENTS.
- b. APPLIES WHERE EXISTING PAVED DRIVE IS TO BE REMOVED FOR ROADWAY CONSTRUCTION AND/OR TO ACHIEVE VERTICAL GEOMETRY REQUIREMENTS. PAVEMENT SHALL EXTEND TO FORM CURB OR SIDEWALK ON ONE SIDE OF DRIVE. DRIVE SHALL BE FINISHED FAMILY REINFORCED NON-COMMERICAL STRUCTURE TYPE CONNECTIONS AND E5 FOR COUNTER GENERATOR ISOGEOMETRIC TYPE CONNECTIONS, OR AS PER THE PLANS.
- c. ASPHALTIC CONCRETE FOR PAVED DRIVES SHALL BE ASPHALTIC CONCRETE WEARING COURSE - OR AT THE OPTION OF THE CONTRACTOR, SHOULDER MIX MAY BE USED. ALSO, WHEN PAVED DRIVES ARE PLACED IN TWO LIFTS, BINDER COURSE MAY BE USED IN THE FIRST LIFT.
- d. COMPACTION OF SUBGRADE AND GRADING WORK FOR CONSTRUCTION OF THE PAVED DRIVES SHALL BE SATISFACTORY TO THE ENGINEER AND PAYMENT SHALL BE MADE UPON THE DRAINAGE ITEMS
- e. MAXIMUM DRIVEWAY GRADE SHALL BE 20% LESS THAN SPECIAL CASES. MAXIMUM RISE IN GRADE SHALL BE 6% OR NOT LESS THAN 1% IN ANY CASE.

ADDITIONAL NOTES (FOR OVERLAY PROJECTS):

1. ASPHALTIC CONCRETE FOR PAVED DRIVES SHALL BE ASPHALTIC CONCRETE WEARING COURSE. AT THE OPTION OF THE CONTRACTOR, SHOULDER MIX MAY BE USED, ALONG, WHEN PAVED DRIVES ARE PLACED IN TWO LIFTS, BINDER COURSE MAY BE USED IN THE FIRST LIFT.
2. DRIVE WIDTHS AND FLARES MAY BE REDUCED TO LESS THAN MINIMUMS SHOWN, AS NECESSARY TO MEET EXISTING CONDITIONS, REDUCE DIMENSIONS WHERE REQUIRED TO AVOID INTERFERENCE WITH EXISTING OR TO PROVIDE EARTHWORK ITEMS, TO BE APPROVED/CORRECTED BY THE PROJECT ENGINEER.
3. LENGTH TO BE SET BY PROJECT ENGINEER TO ACHIEVE A SUITABLE CONNECTION FOR EXISTING DRIVE.
4. ASPHALTIC CONCRETE TRANSITION TO BE CONSTRUCTED AS DIRECTED BY THE PROJECT ENGINEER, TO APPLY FOR EXISTING SURFACED DRIVE, OR PARKING AREA, THE TRANSITION MAY BE CONSTRUCTED USING THE SAME ASPHALTIC CONCRETE MIXTURE.

Bid No.: 50-00117630
Addendum No. 1

[illegible]



CENTRALBIDDING
FROM CENTRAL AUCTION HOUSE

5000117630 RIVER ROAD WATER LINE REPLACEMENT PHASE 2
Jefferson Parish Government

Project documents obtained from www.CentralBidding.com
04-Oct-2016 09:53:37 AM

William E. R.

CONTRACT DOCUMENTS, SPECIFICATIONS
AND
CONTRACT DRAWINGS
FOR

JEFFERSON PARISH
DEPARTMENT OF WATER

RIVER RD. WATERLINE REPLACEMENT
RIVET BLVD. TO WILLSWOOD LANE

PROJECT NO. 2015-049-WR
PROPOSAL NO. 50-00117630

ADDENDUM NO. 2

DATE ISSUED: October 3, 2016

BID DATE: October 13, 2016 at 2:00 PM
(Extended from October 4, 2016)

BID LOCATION: Jefferson Parish General Government Building
Jefferson Parish Purchasing Dept., Suite 4400
200 Derbigny St., Gretna, LA 70053


This addendum shall be part of the Contract Documents as provided in the Instructions to Bidders.

The following items are issued to add to, modify, and clarify the Contract Documents. These items shall have full force and effect as the Contract Documents, and the cost involved shall be included in the bid prices.

Acknowledge receipt of the addendum by inserting its number and date on the Bid Form of the Bid Documents. Failure to do so may subject the bidder to disqualifications.

This Addendum No. 2 consists of 2 pages including the title sheet and all attachments.

Bid Proposal No. 50-00117630

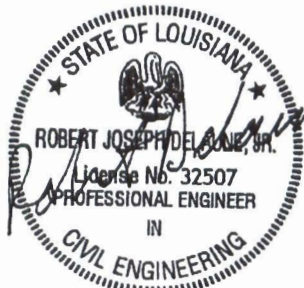

Addendum No. 2

10-3-16

General

Bid opening on this project is postponed for seven working days to October 13, 2016.

- Reason for postponement:
Finalizing utility permit with the Louisiana Department of Transportation and Development
- Further clarification will be issued under separate addendum.

END OF ADDENDUM



CENTRALBIDDING
FROM CENTRAL AUCTION HOUSE

5000117630 RIVER ROAD WATERLINE REPLACEMENT PHASE 2
Jefferson Parish Government

Project documents obtained from www.CentralBidding.com
10-Oct-2016 12:59:21 PM

Wep
C
NS

CONTRACT DOCUMENTS, SPECIFICATIONS
AND
CONTRACT DRAWINGS
FOR
JEFFERSON PARISH
DEPARTMENT OF WATER
RIVER RD. WATERLINE REPLACEMENT
RIVET BLVD. TO WILLSWOOD LANE
PROJECT NO. 2015-049-WR
PROPOSAL NO. 50-00117630

ADDENDUM NO. 3

DATE ISSUED: October 10, 2016

BID DATE: *Change* October 25, 2016 at 2:00 PM
(Extended from October 13, 2016)

BID LOCATION: Jefferson Parish General Government Building
Jefferson Parish Purchasing Dept., Suite 4400
200 Derbigny St., Gretna, LA 70053


This addendum shall be part of the Contract Documents as provided in the Instructions to Bidders.

The following items are issued to add to, modify, and clarify the Contract Documents. These items shall have full force and effect as the Contract Documents, and the cost involved shall be included in the bid prices.

Acknowledge receipt of the addendum by inserting its number and date on the Bid Form of the Bid Documents. Failure to do so may subject the bidder to disqualifications.

This Addendum No. 3 consists of 40 pages including the title sheet and all attachments.

Bid Proposal No. 50-00117630

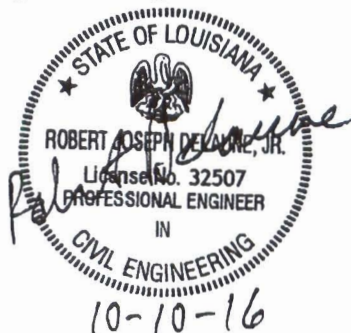

Addendum No. 3

General

Asphalt Patching and Restoration Requirements

All areas of asphalt roadway and driveways which are impacted by construction of the waterline are to receive a 12" temporary asphaltic pavement patch as per the details on Sheet 35 of the plans at the conclusion of each working day. Work associated with Asphalt Patching shall be paid under

510-01-00100 – Asphalt Patching

Fourteen (14) days after the completion of installation of any asphalt patch within roadways, one-half to one full lane of the roadway (does not include asphalt driveways) shall be milled and overlaid (2" thick) as per the details on Sheet 35 of the plans. The pavement patch will remain in place. Backfill requirements for pipe trench shall be as shown on Sheet 33 of the plans. Bid items related to the milling and overlaying of the roadway include:

502-01-00100 – Superpave Asphaltic Pavement

509-01-00100 – Cold Planing Asphaltic Concrete Pavement

Work associated with these items for asphalt patching and restoration shall be performed in accordance with their respective sections of the Louisiana Standard Specifications for Roads and Bridges, 2006 Edition (Blue Book), and latest revisions, or as amended herein.

Louisiana Uniform Public Work Bid Form

The following bid items have been removed from the bid form.

202-02-02000 – Removal of Asphalt Pavement

202-02-02020 – Removal of Asphalt Concrete Pavement

S-004 – Asphalt Patching

The following bid items have been added to the bid form.

510-01-00100 – Asphalt Patching

502-01-00100 – Superpave Asphaltic Pavement

509-01-00100 – Cold Planing Asphaltic Concrete Pavement

Front Ends

A revised bid form dated October 10, 2016 is attached as part of this addendum which includes revised and new items. The item numbers revised or added as part of this addendum include 701-03-00100, 701-03-00101, 510-01-00100, 502-01-00100, 509-01-00100, S-001, W-712, W-901 and S-004.

Drawings

Sheet No. 2 General Notes and Legend

Add the following general note number 19.

19. Fire hydrants and valves shall not be installed within ditches. The fire hydrant ductile iron spool piece shown on the fire hydrant assembly detail on sheet no. 33 shall be extended at no direct pay to move the fire hydrant valve and assembly outside the limits of existing ditches.

Add the following general note number 20.

20. All new driveway pipes installed any diameter in size shall be placed at an elevation that will allow for positive drainage towards the nearest outfall. Before these new driveway pipes are placed, the designated LDOTD District 02 Engineer shall approve the elevation at which the new pipe will be placed. Any new driveway pipes set at an unapproved elevation shall be removed and placed at the proper elevation at no additional cost to the Owner.

Add the following general note number 21.

21. When waterline crosses or runs parallel to the ditch side slope or bottom of ditch three feet of depth shall be required from the ditch side slope or bottom of ditch. If offsets are required to attain three feet of depth clearance the fittings used for offsets will be paid under Item No. W-901.

Sheet No. 4

Quantities have been updated, items were deleted and new items were added.

Sheet No. 6, 7, 10, 11, 12, 20, 21, and 22

Revised waterline alignment.

Sheet No. 8

Offset below drain manhole.

Sheet No. 9

Removed air release valve.

Sheet No. 16

Revised minimum clearance to 3 feet for waterline offset.

Sheet No. 19

Added 24" RCP drain pipe installation.

Sheet No. 32

Added drainage ditch and offset.

Sheet No. 35

Removed ARV detail and Trench Near Edge of Roadway Detail. Added concrete bollard detail and Typical Section – Trench in Roadway detail.

Jefferson Parish Typical Roadway Restoration Detail Issued in Addendum No. 1

The asphalt replacement over trench on this detail sheet shall not be used. A new detail for asphalt pavement trench in roadway is included in this addendum and shall be used for asphalt removal and replacement on this project.

Technical Specifications

Section 01025

Delete Section 01025-4.04 REMOVAL OF ASPHALT PAVEMENT (ITEM NO. 202-02-02000)

Delete Section 01025-4.06 REMOVAL OF ASPHALTIC CONCRETE PAVEMENT (ITEM NO. 202-02-02020)

Delete Section 01025-4.09 24" RCP DRIVEWAY PIPE REPLACEMENT (ITEM NO. 701-03) and replace with the following:

4.09 24" RCP NEW DRIVEWAY PIPE (ITEM NO. 701-03-00100)

- A. Measurement: Measurement for payment for 24" RCP Driveway Pipe Replacement will be made on a per each basis.
- B. Payment: Payment for this item will be made at the per each price bid and will constitute full compensation for providing all labor, materials, equipment and incidentals required for removing the existing driveway pipe if necessary as instructed by the engineer and installing a new 24" RCP driveway pipe. Excavation, geotextile fabric, backfill, bedding material, and all incidentals required for removal if necessary and installation of the 24" RCP pipe shall be included in the unit price for this item.

Delete Section 01025-4.18 ASPHALT PATCHING (ITEM NO. S-004)

Delete Section 01025-4.34 AIR RELEASE VALVE WITH MANHOLE (ITEM NO. NS-P55-23500) and replace with the following:

4.34 18" RCP NEW DRIVEWAY PIPE (ITEM NO. 701-03-00101)

- A. Measurement: Measurement for payment for 18" RCP Driveway Pipe Replacement will be made on a per each basis.
- B. Payment: Payment for this item will be made at the per each price bid and will constitute full compensation for providing all labor, materials, equipment and incidentals required for removing the existing driveway pipe if necessary as instructed by the engineer and installing a new 18" RCP driveway pipe. Excavation, geotextile fabric, backfill, bedding

material, and all incidentals required for removal if necessary and installation of the 18" RCP pipe shall be included in the unit price for this item.

Add the following to the end of the Measurement and Payment Section:

4.41 REMOVE AND REPLACE CONCRETE BOLLARDS (ITEM NO. S-001)

- A. Measurement: Measurement for payment for removal and replacement of concrete bollards will be made on a per each basis.
- B. Payment: Payment for this item will be made at the per each price bid and will constitute full compensation for providing all labor, materials, equipment and incidentals required for removal and replacement of concrete bollards

4.42. REMOVE AND REPLACE WOODEN BOLLARDS (ITEM NO. S-004)

- A. Measurement: Measurement for payment for removal and replacement of wooden bollards will be made on a per each basis.
- B. Payment: Payment for this item will be made at the per each price bid and will constitute full compensation for providing all labor, materials, equipment and incidentals required for removal and replacement of wooden bollards.

Section 02060

This section shall be added to the project construction specifications and is included with this addendum.

Section 02070

The existing specification section shall be deleted in its entirety and replace with the new section enclosed with this specification.

Note: The following items are attached and are hereby made part of this addendum:

- a) Additional Contractor's questions submitted in writing
- b) Revised Sheet Nos. 4, 6, 7, 8, 9, 10, 11, 12, 16, 19, 20, 21, 22, 32, 35
- c) Revised Louisiana Uniform Public Work Bid Form dated October 10, 2016
- d) West Jefferson Levee District Permit (For reference only. Fully executed permit will be provided to the Contractor that is awarded the project as low bidder)
- e) Section 02060 – Asphaltic Concrete
- f) Section 02070 – Asphaltic Concrete Pavement Patching

END OF ADDENDUM

River Rd. Waterline Replacement Phase 2
Willswood Lane to Rivet Blvd.
Contractor Questions and Answers

Global Contractors Questions and Answers

Question 1: Asphalt removal and replacement is somewhat confusing. A new Asphalt Restoration drawing was issued with addendum no. 1 and should take precedence. It calls for 6" (previously 12" polymer). It also calls out to use a 6" binder course for temporary 6" binder to be removed prior to permanent asphalt replacement. Can you add an item for saw cut? Can you add an item for the temporary binder course? Will the Traffic Maintenance Aggregate Item still be used and paid for prior to the temporary asphalt? Can you delete Specification Section 02070 Asphalt Concrete Pavement Patching and replace with a new Measurement and Payment to reflect the new asphalt restoration drawing? Section 02070 calls for 12" thick Polymer Asphalt and the new drawing calls for 4" Binder and 2" Type III wearing course.

Answer 1: A new asphalt patching detail is included in this addendum and the bid items, measurement and payment and asphalt concrete pavement patching technical specification has been revised to clarify asphalt removal and replacement.

Question 2: Drawing Sheet 35 Typical Section Trench near edge of Roadway: Does this detail still apply? Does the 12" thick Asphalt still apply? Does the mill and overlay still apply? How will all this be paid? This detail refers to Drawing Sht 36 which is "Drainage Pipe Details" (Trench Width OD + 4'). Does this detail only apply to drainage pipe installations? I am assuming we are to go by the Waterline Trench Detail on Drawing Sht 33 (Trench Width OD +2').

Answer 2: See answer to question number 1. Trench near edge of roadway detail has been removed.

Subterranean Construction, LLC

Question 1: Can you please re-visit your answer to Boh Brothers question 1 regarding sand backfill. I understand that the Jefferson Parish standard detail says to backfill with sand in streets right of way but if that was the case then every water and sewer line in the parish would get backfilled with sand because they are all in the street right of way. When we are doing subdivisions we only backfill the drain with sand because it is close to the back of curb, all sewer and water lines are backfilled with existing material. Also, by backfilling entirely with sand most of the mud will have to be loaded on trucks and hauled off which to me will change the scope of the project and require ongoing lane closures. I can't recall if your firm engineered the last phase of this project but I can tell you on that project the contractor backfilled with the existing material.



Answer 1: Backfill on the first phase of the project was river sand. River sand will be required as backfill in trenches on this project.



BID PROPOSAL No. 50-00117630
ADDENDUM No.3

- NOTES:
1. ALL STATIONING IS FROM SPW BASELINE "BL".
 2. PROVIDE 3 FOOT MINIMUM COVER FOR NEW WATERLINE.
 3. CONTRACTOR TO LOCATE DOMESTIC AND FIRE SERVICES IN FIELD AND CONNECT SERVICE TO NEW WATERLINE.
 4. WATERLINE FITTING LOCATIONS ARE FOR INFORMATIONAL PURPOSES ONLY. ACTUAL FIELD LOCATIONS MAY VARY.
 5. EXISTING 8" WATERLINE MUST REMAIN IN SERVICE AT ALL TIMES DURING CONSTRUCTION.

THE #2 IS A BEE HIVE SET IN THE EAST FACE OF A POWER POLE LOCATED APPROXIMATELY 15 FEET WEST OF EXISTING DRIVE AND 15 FEET NORTH OF RIVER ROAD AS SHOWN HEREON. REPOSITION THIS #2 HIVE IN CASE 1A.

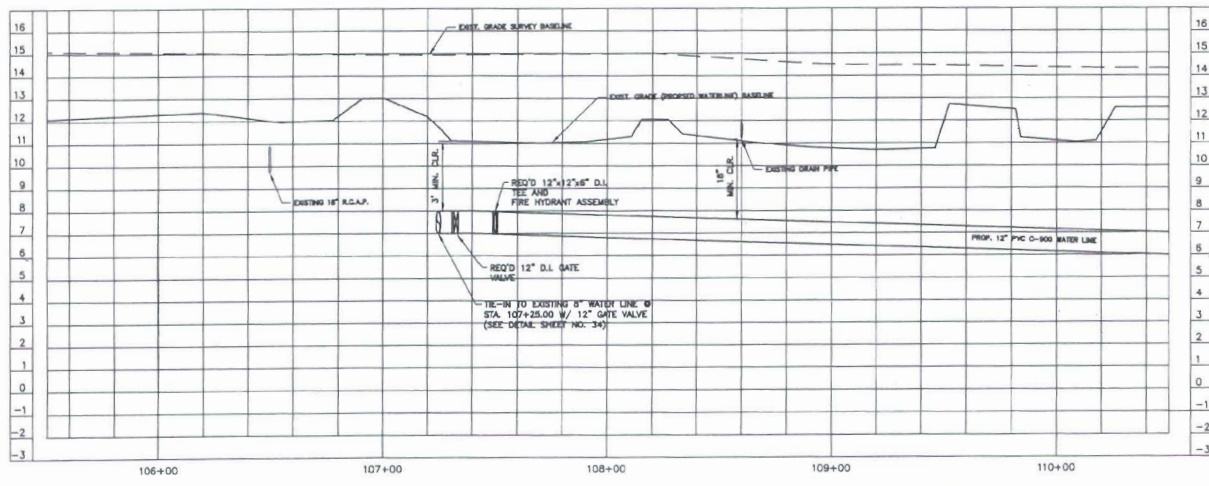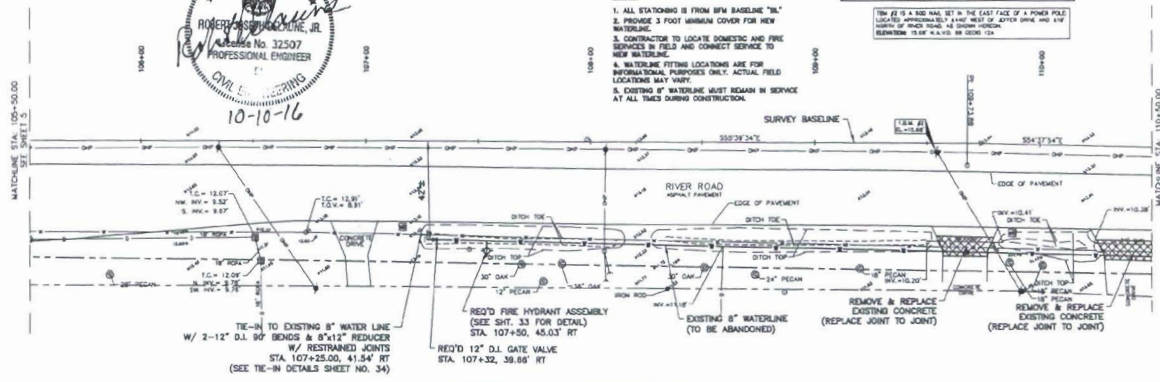


NO.	REVISION	DATE
1	ISSUED FOR BIDDING	10/10/16
2	ISSUED FOR BIDDING	10/10/16
LA DEPARTMENT OF HIGHWAYS & TRANSPORTATION
RIVER ROAD WATER LINE REPLACEMENT
RIVER BOULEVARD TO PARISH LINE
PLAN & PROFILE SHEET
STA. 106+50 TO STA. 110+50

PROJECT NO. 514-01
DATE OCTOBER 2016
SCALE
SHEET NO. 8

BID PROPOSAL No. 50-00117630
ADDENDUM No.3


- NOTES:
1. ALL STATIONING IS FROM R/W BASELINE "BL".
 2. PROVIDE 3 FOOT WIDENING COVER FOR NEW WATERLINE. CONTRACTOR TO LOCATE DOMESTIC AND FIRE SERVICES IN FIELD AND CONNECT SERVICE TO NEW WATERLINE.
 3. WATERLINE FITTING LOCATIONS ARE FOR INFORMATIONAL PURPOSES ONLY. ACTUAL FIELD LOCATIONS MAY VARY.
 4. EXISTING 8" WATERLINE MUST REMAIN IN SERVICE AT ALL TIMES DURING CONSTRUCTION.

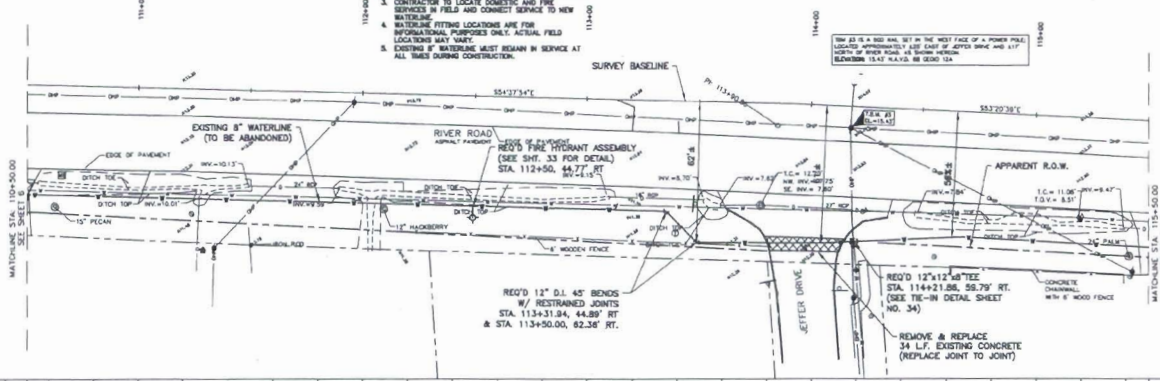

SCALE: 1"=20'



10-10-26

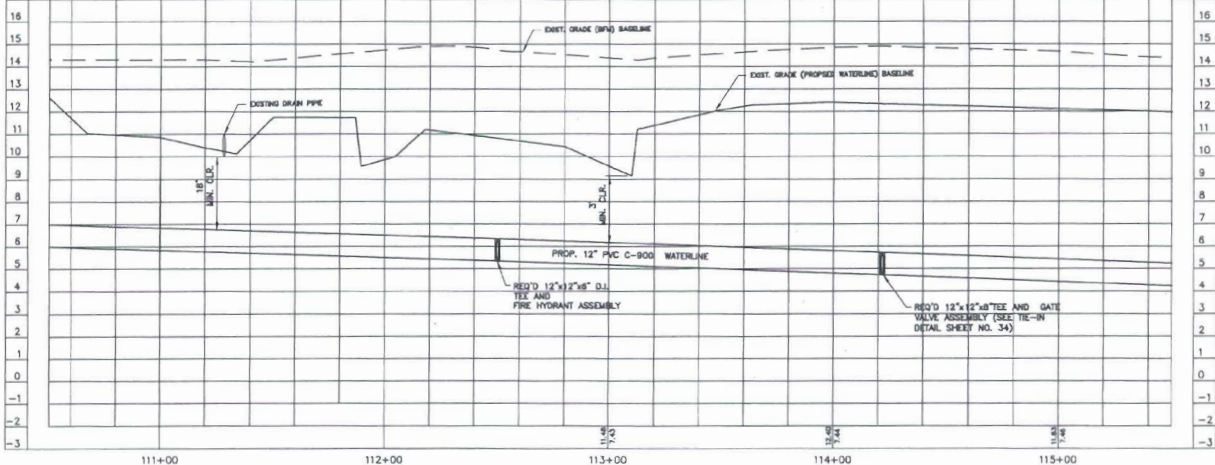


LA DEPARTMENT OF HEALTH & HOSPITALS
RIVER ROAD WATER LINE REPLACEMENT
RIVET BOULEVARD TO PARISH LINE
PLAN & PROFILE SHEET
STA. 110+50 TO STA. 115+50

PROJECT NO. 514-07
DATE: OCTOBER 2016
SHEET NO. 7


BID PROPOSAL No. 50-00117830
ADDENDUM No.3

- NOTES:
1. ALL STATIONING IS FROM R/W BASELINE "01".
 2. PROVIDE 3 FOOT MINIMUM COVER FOR NEW WATERLINE.
 3. CONTRACTOR TO LOCATE DOMESTIC AND FIRE SERVICES IN FIELD AND CONNECT SERVICE TO NEW WATERLINE.
 4. WATERLINE FITTING LOCATIONS ARE FOR INFORMATIONAL PURPOSES ONLY. ACTUAL FIELD LOCATIONS MAY VARY.
 5. EXISTING 8" WATERLINE MUST REMAIN IN SERVICE AT ALL TIMES DURING CONSTRUCTION.


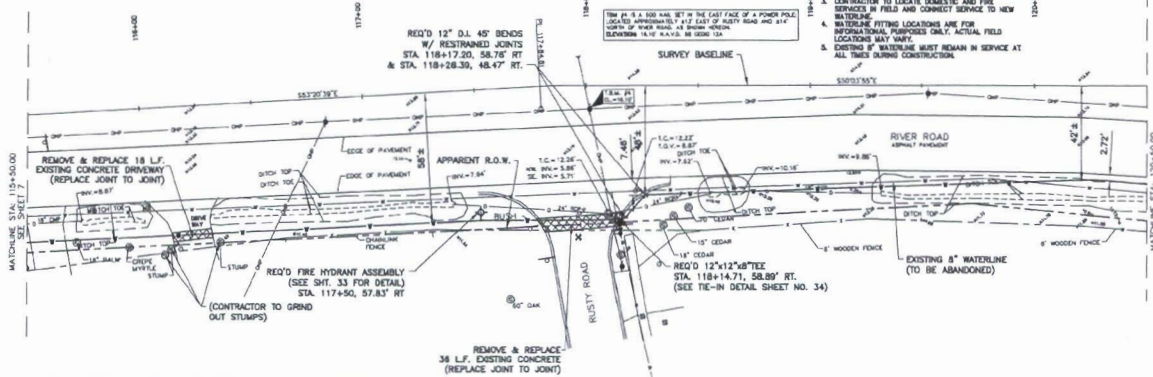


10-10-16

digital engineering
L.A. DEPARTMENT OF HEALTH & HOSPITALS
RIVER ROAD WATER LINE REPLACEMENT
RIVER BOULEVARD TO PARISH LINE
PLAN & PROFILE SHEET
STA. 114+50 TO STA. 120+50
PROJECT NO. 514-01
DATE: OCTOBER 2018
SCALE
SHEET NO. 8

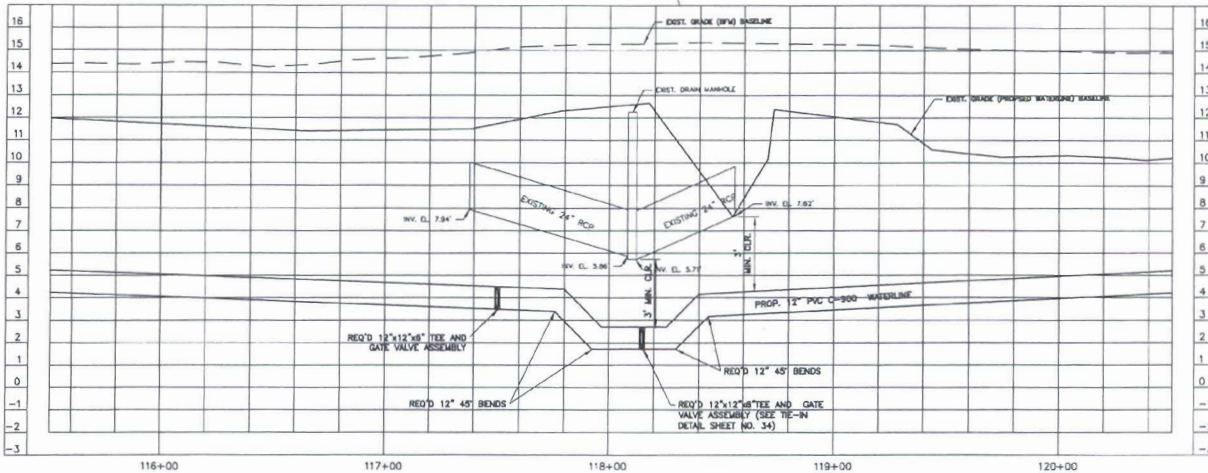

10-10-16

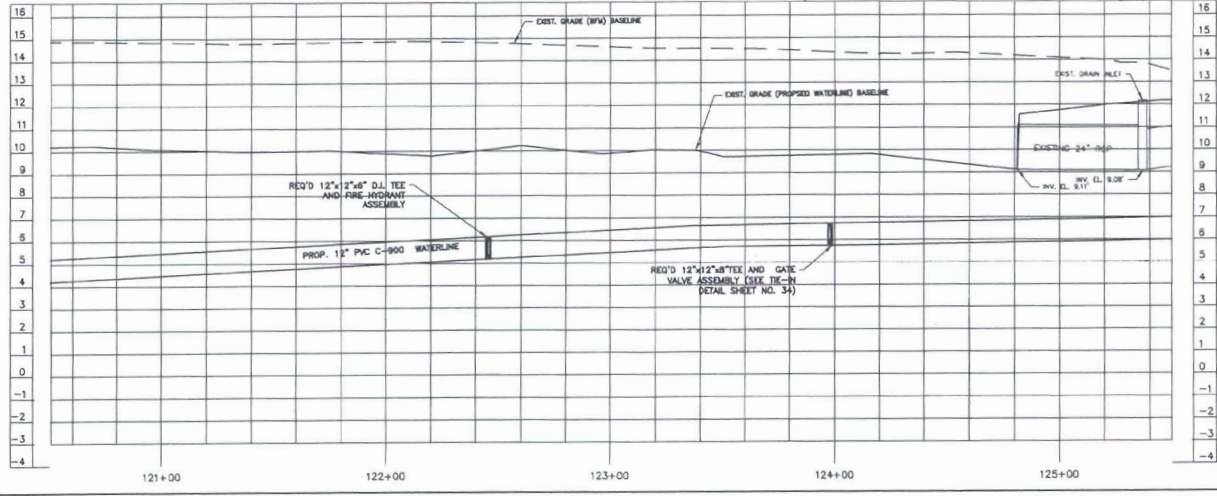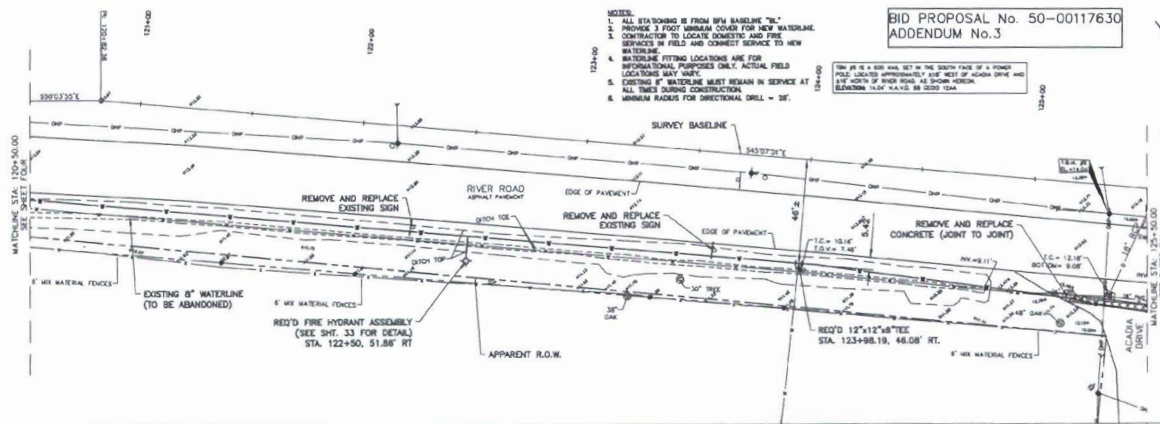

digital engineering


LA DEPARTMENT OF HEALTH & HOSPITALS
RIVER ROAD WATERLINE REPLACEMENT
RIVER BOULEVARD TO PARISH LINE
PLAN & PROFILE SHEET
STA. 120+50 TO STA. 125+50

PROJECT NO. 514-01
DATE: OCTOBER 2016
SCALE
SHEET NO. 2


BID PROPOSAL No. 50-00117630
ADDENDUM No.3

- NOTES:
1. ALL STATIONING IS FROM R/W BASELINE "BL".
 2. PROVIDE 3 FOOT MINIMUM COVER FOR NEW WATERLINE.
 3. CONTRACTOR TO LOCATE DOMESTIC AND FIRE SERVICES IN FIELD AND CORRECT SERVICE TO NEW WATERLINE.
 4. WATERLINE FITTING LOCATIONS ARE FOR INFORMATIONAL PURPOSES ONLY. ACTUAL FIELD LOCATIONS MAY VARY.
 5. EXISTING 8" WATERLINE MUST REMAIN IN SERVICE AT ALL TIMES DURING CONSTRUCTION.
 6. MINIMUM RADIUS FOR DIRECTIONAL DRILL = 30'.
 7. CONTRACTOR SHALL RE-INSTALL ALL BOLLARDS DAMAGED OR DISTURBED DURING CONSTRUCTION AT NO ADDITIONAL COST TO THE OWNER.
 8. CONTRACTOR SHALL REPLACE ALL BOLLARDS DAMAGED DURING CONSTRUCTION AT NO ADDITIONAL COST TO THE OWNER.

SCALE: 1"=20'

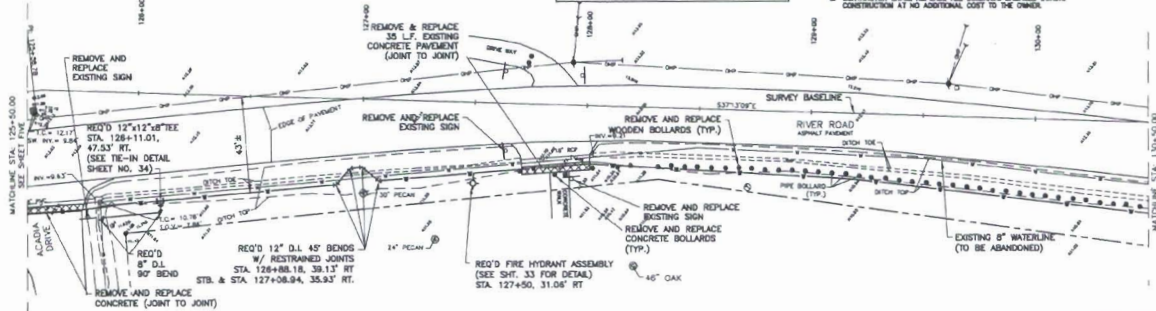

10-10-16

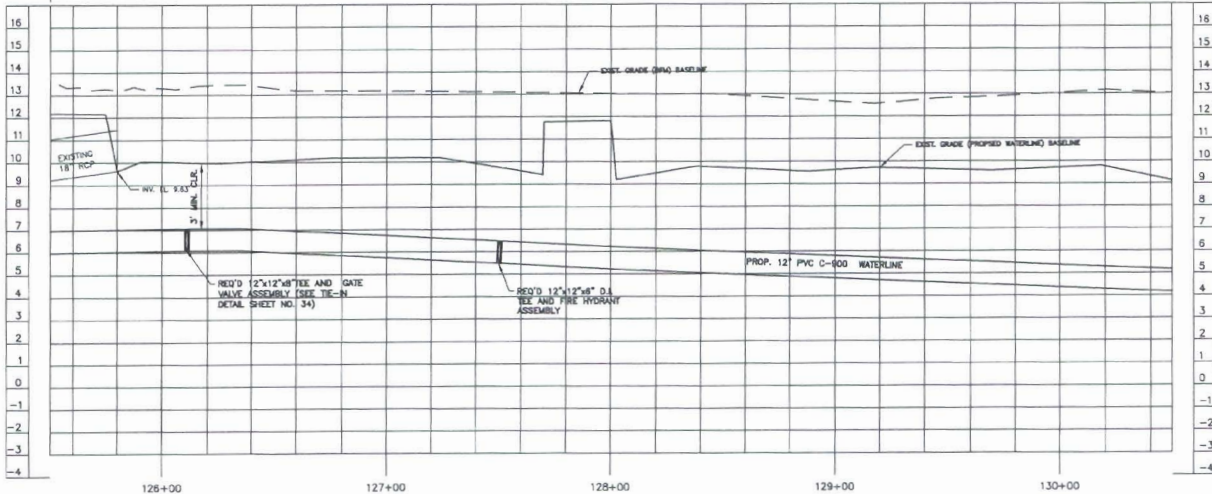

digital engineering


LA DEPARTMENT OF HEALTH & HOSPITALS
RIVER ROAD WATER LINE REPLACEMENT
RIVER BOULEVARD TO PARKWAY LINE
PLAN & PROFILE SHEET
STA. 125+00 TO STA. 130+00

PROJECT NO. 514-37
DATE: OCTOBER 2016
SCALE:
SHEET NO. 10

THE 1/4" IS A 300' HORIZ. SET IN THE SOUTH FACE OF A POWER POLE LOCATED APPROXIMATELY 150' WEST OF LIVE OAK MANOR DRIVE AND 150' NORTH OF POWER POLE. AS SHOWN HEREIN. ELEVATION 132.15' M.A.S.L. AS SHOWN HEREIN.

BID PROPOSAL No. 50-00117630 ADDENDUM No.3

- NOTES:
1. ALL STATIONING IS FROM NEW BASELINE "B".
 2. PROVIDE 3 FOOT MINIMUM COVER FOR NEW WATERLINE. CONTRACTOR TO LOCATE DOMESTIC AND FIRE SERVICES IN FIELD AND CONNECT SERVICE TO NEW WATERLINE.
 3. WATERLINE FITTING LOCATIONS ARE FOR INFORMATIONAL PURPOSES ONLY. ACTUAL FIELD LOCATIONS MAY VARY.
 4. EXISTING 8" WATERLINE MEET HEADIN IN SERVICE AT ALL TIMES DURING CONSTRUCTION.
 5. PROVIDE 4 MINIMUM CLEARANCE FROM EXISTING WOODEN BOLLARDS TO ENSURE EXISTING BOLLARDS ARE NOT DISTURBED.

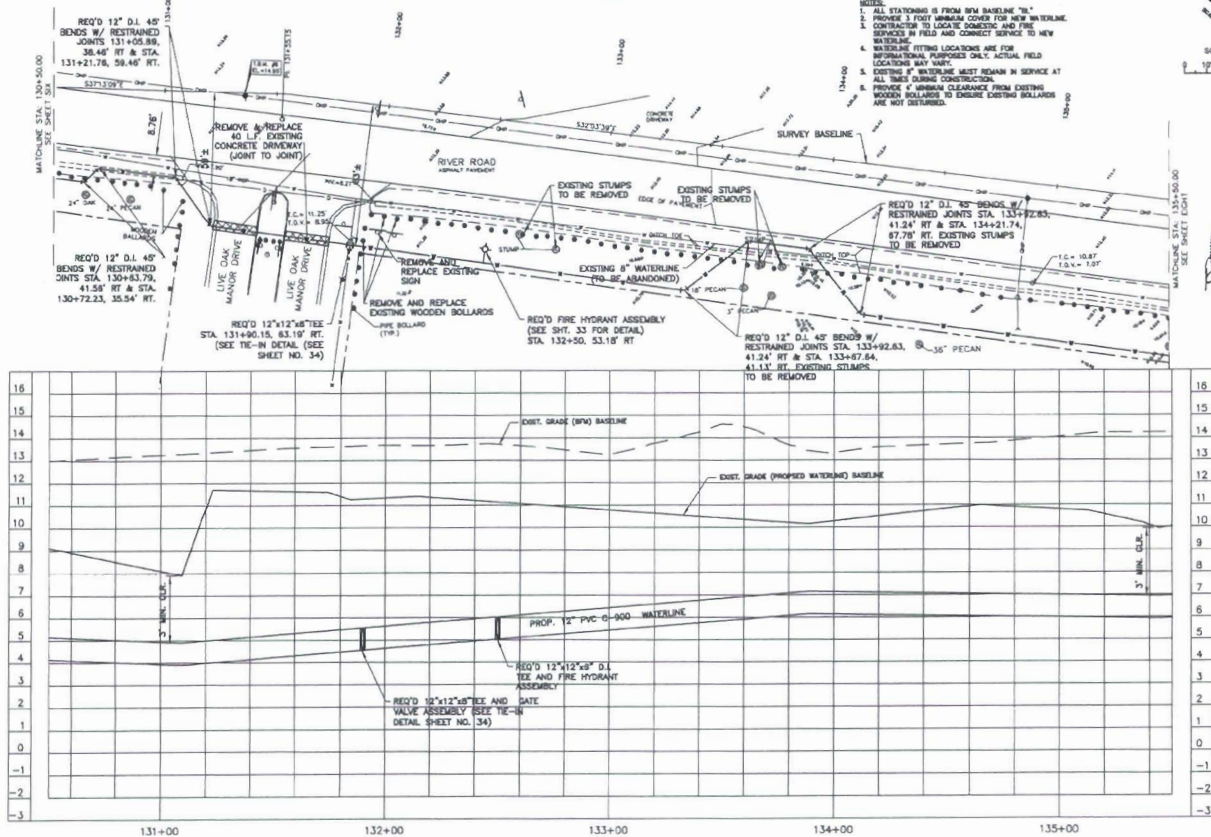

digital engineering

STATE OF LOUISIANA
DEPARTMENT OF REVENUE & HERITAGE
RIVER ROAD WATER LINE REPLACEMENT
PLAN & PROFILE SHEET
STA. 130+50 TO STA. 135+50

PROJECT NO. 514-01
DATE: OCTOBER 2016
SCALE
SHEET NO. 11

THIS DRAWING IS THE PROPERTY OF THE STATE OF LOUISIANA. IT IS TO BE USED ONLY FOR THE PROJECT AND LOCATION SPECIFICALLY IDENTIFIED HEREON. IT IS NOT TO BE REPRODUCED OR TRANSMITTED IN ANY FORM OR BY ANY MEANS, ELECTRONIC OR MECHANICAL, INCLUDING PHOTOCOPYING, RECORDING, OR BY ANY INFORMATION STORAGE AND RETRIEVAL SYSTEM, WITHOUT PERMISSION IN WRITING FROM THE STATE OF LOUISIANA.

This is a 500 WAX SET IN THE WEST FACE OF A POWER POLE. LOCATED APPROXIMATELY 217 NORTH OF AZALEA DRIVE AND 218 NORTH OF RIVER ROAD. AS SHOWN HEREIN.
ELEVATION 13.29 N.A.V.D. 88 DEOD 12A.

This is a 500 WAX SET IN THE WEST FACE OF A POWER POLE. LOCATED APPROXIMATELY 217 NORTH OF AZALEA DRIVE AND 218 NORTH OF RIVER ROAD. AS SHOWN HEREIN.
ELEVATION 13.29 N.A.V.D. 88 DEOD 12A.



NOTES:

1. ALL STATIONING IS FROM BFM BASELINE "BL".
2. PROVIDE 3 FOOT MINIMUM COVER FOR NEW WATERLINE.
3. CONTRACTOR TO LOCATE DOMESTIC AND FIRE SERVICES IN FIELD AND CONNECT SERVICE TO NEW WATERLINE.
4. WATERLINE FITTING LOCATIONS ARE FOR INFORMATIONAL PURPOSES ONLY. ACTUAL FIELD LOCATIONS MAY VARY.
5. DUSTING IF WATERLINE MUST REMAIN IN SERVICE AT ALL TIMES DURING CONSTRUCTION.

STATE OF LOUISIANA
 ROBERT L. DWYER, JR.
 License No. 82507
 PROFESSIONAL ENGINEER
 IN
 CIVIL ENGINEERING



**digital
engineering**
527 W. ESPERANZA AVE., STE. 200 • KENNER, LA 70149
PHONE 504.442.8127

DEPARTMENT OF HEALTH & HOSPITALS
RIVER ROAD WATER LINE REPLACEMENT
RIVET BOULEVARD TO PARISH LINE
PLAN & PROFILE SHEET



PROJECT NO. 514-0
DATE OCTOBER 2011
SCALE
SHEET NO. 12

© 2000 Blackwell Science Ltd
Journal of Internal Medicine 247: 115-121

BID PROPOSAL No. 50-0017630
ADDENDUM No.3

THEY ARE TO BE SET IN THE SOUTH FACE OF A POWER
POLY LOCATIONS APPROXIMATELY 10 FEET NORTH OF SHANTON DRIVE
AND EAST OF RIVER ROAD AS SHOWN HEREON.
REVISION: 10/27/10 BY 10000 10

- NOTES:
1. ALL STATIONING IS FROM SPW BASELINE "BL".
 2. PROVIDE 3 FOOT MINIMUM COVER FOR NEW WATERLINE. CONTRACTOR TO LOCATE DOMESTIC AND FIRE SERVICES IN FIELD AND CONNECT SERVICE TO NEW WATERLINE.
 3. WATERLINE FITTING LOCATIONS ARE FOR INFORMATIONAL PURPOSES ONLY. ACTUAL FIELD LOCATIONS MAY VARY.
 4. EXISTING 8" WATERLINE MUST REMAIN IN SERVICE AT ALL TIMES DURING CONSTRUCTION.
 5. MINIMUM RADIUS FOR DIRECTIONAL DRILL = 35'.

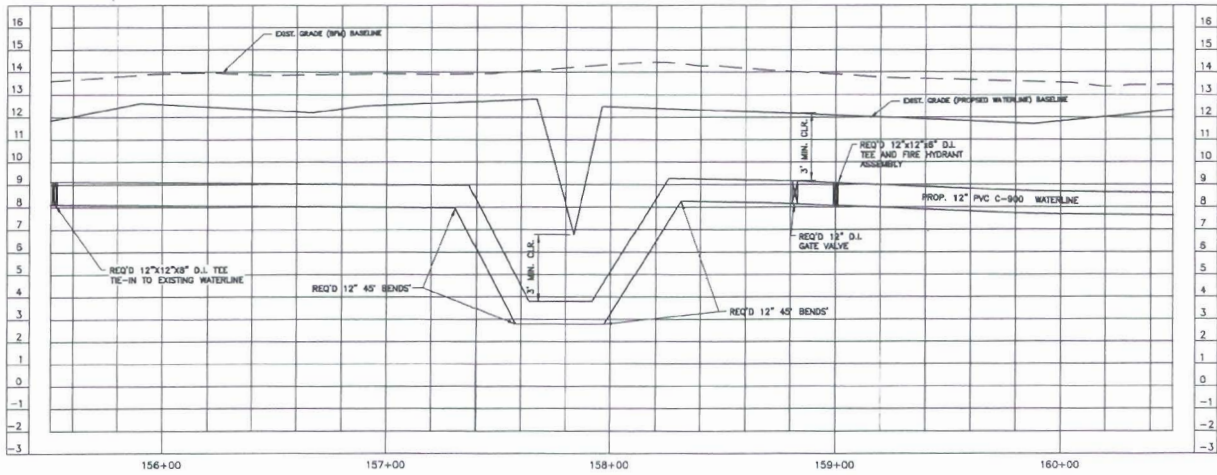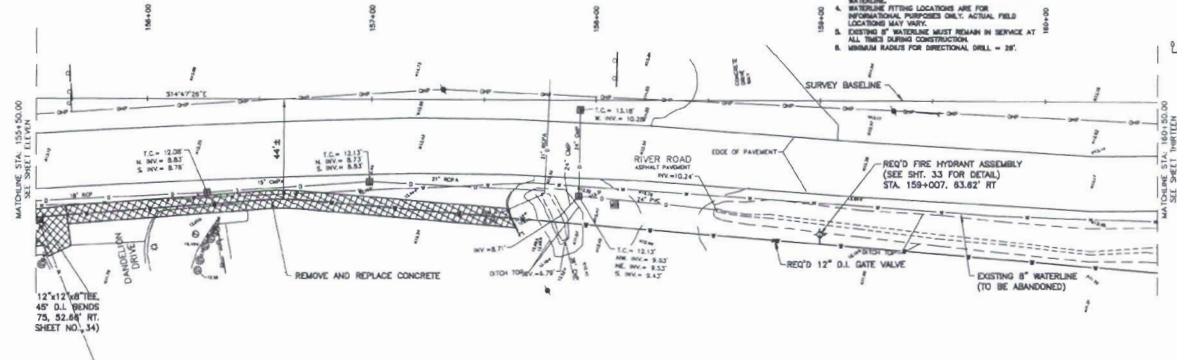

digital
engineering


LA DEPARTMENT OF HEALTH & HOSPITALS
RIVER ROAD WATERLINE REPLACEMENT
RIVER BOULEVARD TO PARISH LINE
PLAN & PROFILE SHEET
STA 155+50 TO STA 160+50

PROJECT NO. 514-01
DATE OCTOBER 2010
SHEET NO. 16

NOTES:
1. ALL STATIONING IS FROM NEW BASELINE "BL".
2. PROVIDE 3 FOOT MINIMUM COVER FOR NEW WATERLINE.
3. CONTRACTOR TO LOCATE DOMESTIC AND FIRE SERVICES IN FIELD AND CORRECT SERVICE TO NEW WATERLINE.
4. WATERLINE FITTING LOCATIONS ARE FOR INFORMATIONAL PURPOSES ONLY. ACTUAL FIELD LOCATIONS MAY VARY.
5. EXISTING 8" WATERLINE MUST REMAIN IN SERVICE AT ALL TIMES DURING CONSTRUCTION.

THE PILE IS A 100' H.M. SET IN THE SOUTH FACE OF A PIER
PILE LOCATED APPROXIMATELY 1.0' NORTH OF VINCENT LANE
AND 1.0' EAST OF RIVER ROAD. NO OTHER PILES.
ELEVATION 15.9' M.A.S. SEE SHEET 12A

BID PROPOSAL No. 50-00117630
ADDENDUM No.3

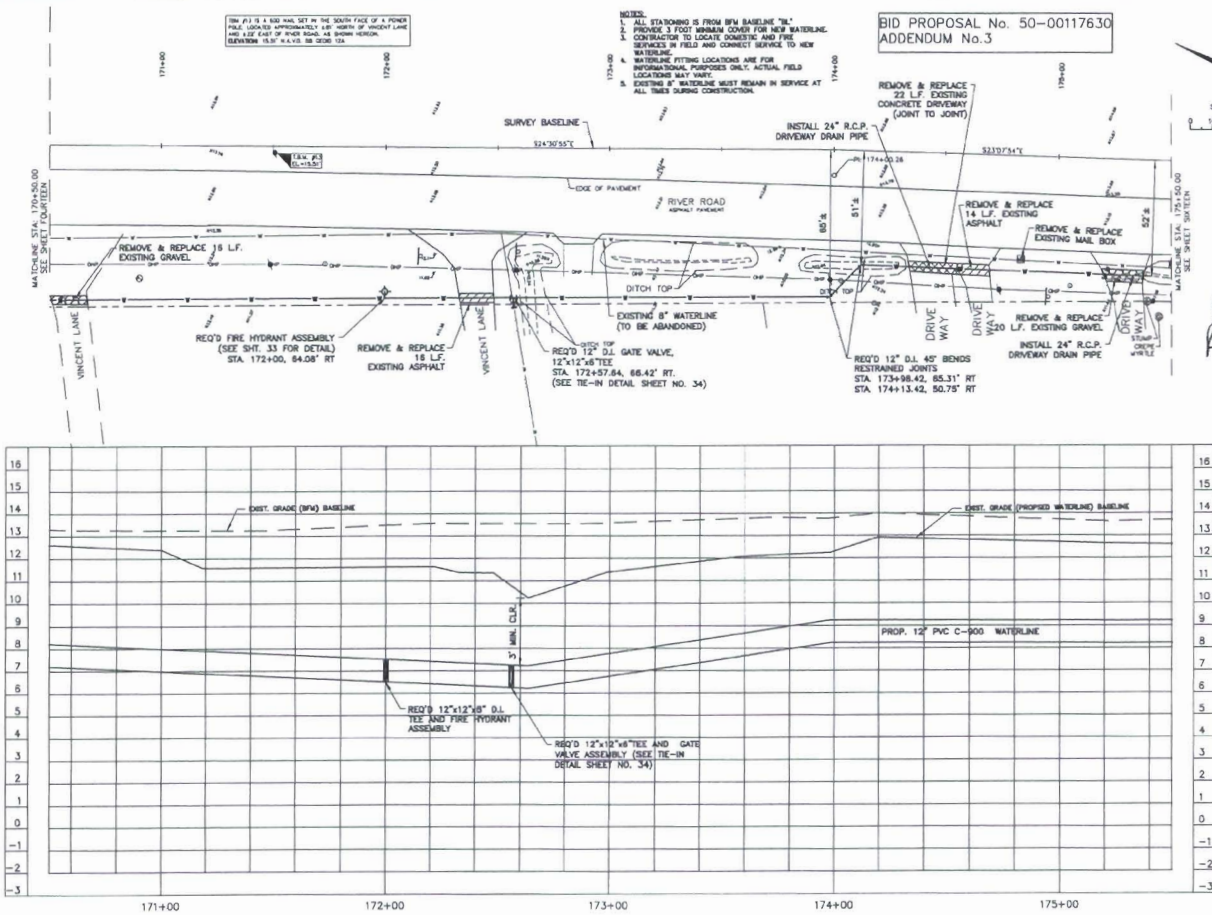

18-10-16






digital engineering
14 DEPARTMENT OF HEALTH & HOSPITALS
RIVER ROAD WATER LINE REPLACEMENT
RIVER BOULEVARD TO PARISH LINE
PLAN & PROFILE SHEET
STA. 170+50 TO STA. 175+50

PROJECT NO. 514-05
DATE: OCTOBER 2016
SCALE
SHEET NO. 19

THE P.U. IS A 500 KVA SET IN THE SOUTH FACE OF A POWER POLE LOCATED APPROXIMATELY 111' NORTH OF PHILIP DRIVE AND 11' EAST OF RIVER ROAD. AS SHOWN HEREIN, BAWBORN TUBE R.A.V.D. IS USED 12"

- NOTES:**
1. ALL STATIONING IS FROM R/W BASELINE "01".
 2. PROVIDE 3 FOOT MINIMUM COVER FOR NEW WATERLINE.
 3. CONTRACTOR TO LOCATE EXISTING AND FIRE SERVICES IN FIELD AND CONNECT SERVICE TO NEW WATERLINE.
 4. WATERLINE FITTING LOCATIONS ARE FOR INFORMATIONAL PURPOSES ONLY. ACTUAL FIELD LOCATIONS MAY VARY.
 5. EXISTING 8" WATERLINE MUST REMAIN IN SERVICE AT ALL TIMES DURING CONSTRUCTION.

BID PROPOSAL No. 50-00117630
ADDENDUM No.3

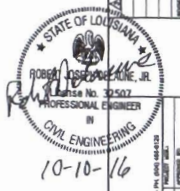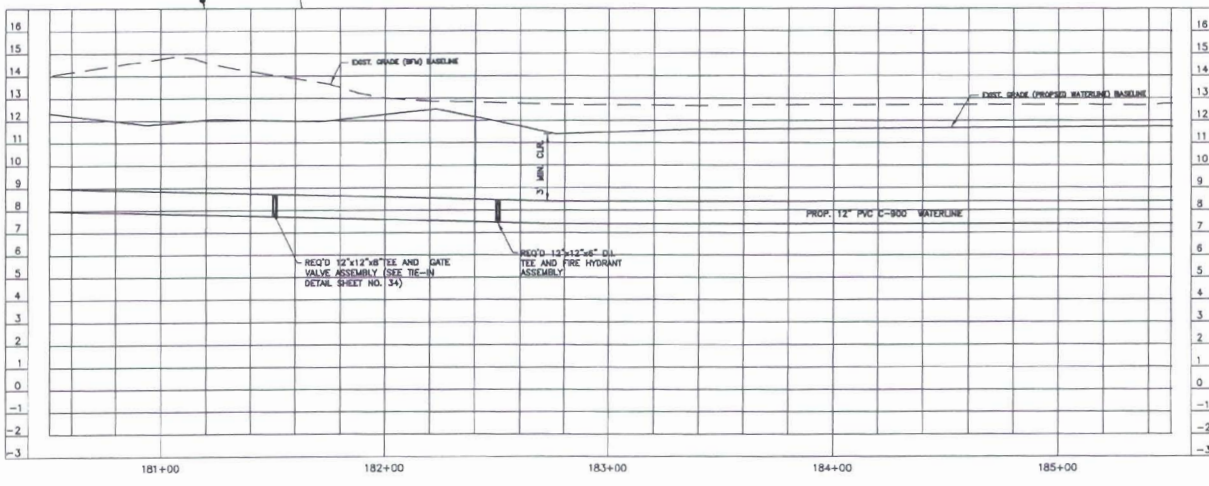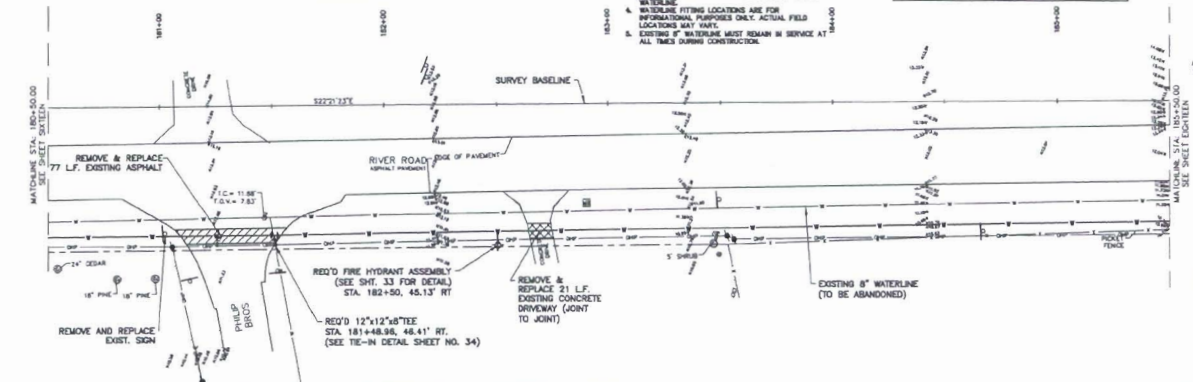

digital engineering
101 N. GARDNER AVE., SUITE 100
BIRMINGHAM, AL 35203
205.988.8888
www.digitalengr.com

LA DEPARTMENT OF HEALTH & HOSPITALS
RIVER ROAD WATER LINE REPLACEMENT
RIVET BOULEVARD TO PARISH LINE
PLAN & PROFILE SHEET
STA. 180+50 TO STA. 185+50


PROJECT NO. 514-91
DATE OCTOBER 2016
SCALE
SHEET NO. 21

THIS DRAWING IS THE PROPERTY OF DIGITAL ENGINEERING. IT IS TO BE USED ONLY FOR THE PROJECT AND SITE SPECIFICALLY IDENTIFIED HEREON. IT IS NOT TO BE REPRODUCED, COPIED, OR TRANSMITTED IN ANY FORM OR BY ANY MEANS, ELECTRONIC OR MECHANICAL, INCLUDING PHOTOCOPYING, RECORDING, OR BY ANY INFORMATION STORAGE AND RETRIEVAL SYSTEM, WITHOUT THE WRITTEN PERMISSION OF DIGITAL ENGINEERING.


NEW P.S. IS AN OPEN HOLE LOCATED APPROXIMATELY 117' NORTH
OF LATIQUE ROAD AND 127' EAST OF RIVER ROAD AS SHOWN
BELOW. 13.57' H.A. X 3.00' H.A. (SEE DETAIL SHEET NO. 34)

**BID PROPOSAL No. 50-00117630
ADDENDUM No.3**

- NOTES:**
1. ALL STATIONING IS FROM R/W BASELINE "B".
 2. PROVIDE 3 FOOT MINIMUM COVER FOR NEW WATERLINE.
 3. CONTRACTOR TO LOCATE EXISTING AND FIRE SERVICES IN FIELD AND CORRECT SERVICE TO NEW WATERLINE.
 4. WATERLINE FITTING LOCATIONS ARE FOR INFORMATIONAL PURPOSES ONLY. ACTUAL FIELD LOCATIONS MAY VARY.
 5. EXISTING 8" WATERLINE MUST REMAIN IN SERVICE AT ALL TIMES DURING CONSTRUCTION.

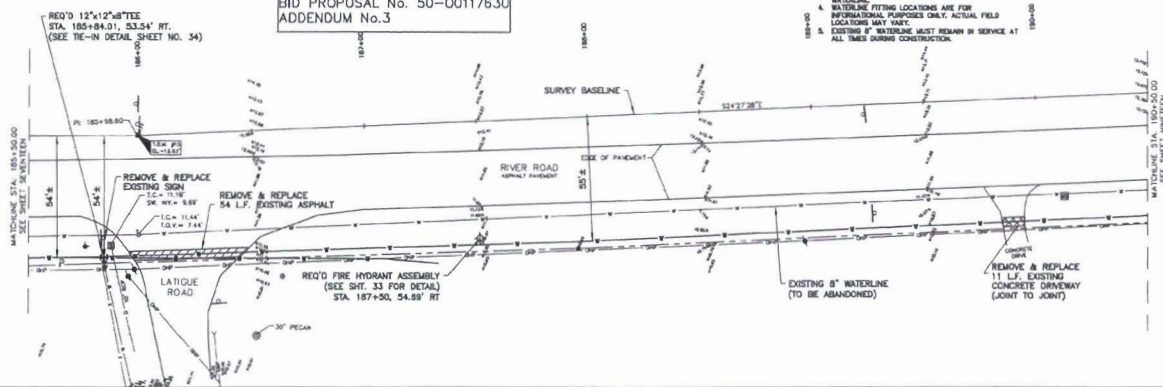

10-10-16


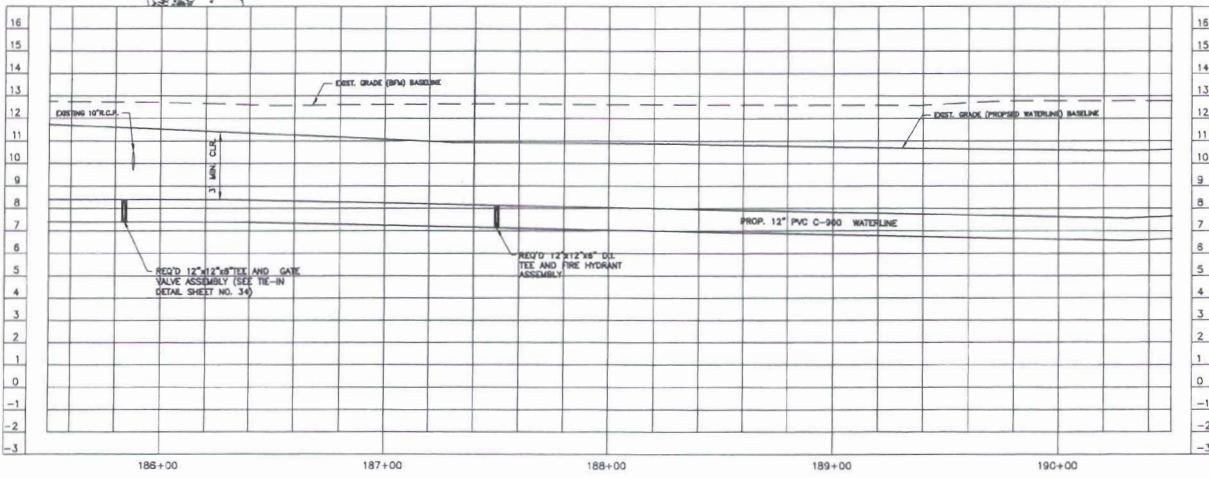


THIS DRAWING IS THE PROPERTY OF THE STATE OF LOUISIANA. IT IS TO BE USED ONLY FOR THE PROJECT AND LOCATION SPECIFICALLY IDENTIFIED HEREON. IT IS NOT TO BE REPRODUCED OR TRANSMITTED IN ANY FORM OR BY ANY MEANS, ELECTRONIC OR MECHANICAL, INCLUDING PHOTOCOPYING, RECORDING, OR BY ANY INFORMATION STORAGE AND RETRIEVAL SYSTEM, WITHOUT PERMISSION IN WRITING FROM THE STATE OF LOUISIANA.


PROJECT NO.	514-81
DATE	OCTOBER 2016
SCALE	
SHEET NO.	22
LA DEPARTMENT OF HEALTH & HOSPITALS RIVER ROAD WATER LINE REPLACEMENT RIVET BOULEVARD TO PARKWAY LINE PLAN & PROFILE SHEET STA. 180+50 TO STA. 190+50	

NOTES:


1. ALL STATIONING IS FROM BFM BASELINE "BL"
2. PROVIDE 3 FOOT MINIMUM COVER FOR NEW WATERLINE
3. CONTRACTOR TO LOCATE DOMESTIC AND FIRE SERVICES IN FIELD AND CONNECT SERVICE TO NEW WATERLINE
4. WATERLINE FITTING LOCATIONS ARE FOR INFORMATIONAL PURPOSES ONLY. ACTUAL FIELD LOCATIONS MAY VARY.
5. EXISTING "S" WATERLINE MUST REMAIN IN SERVICE AT ALL TIMES DURING CONSTRUCTION.

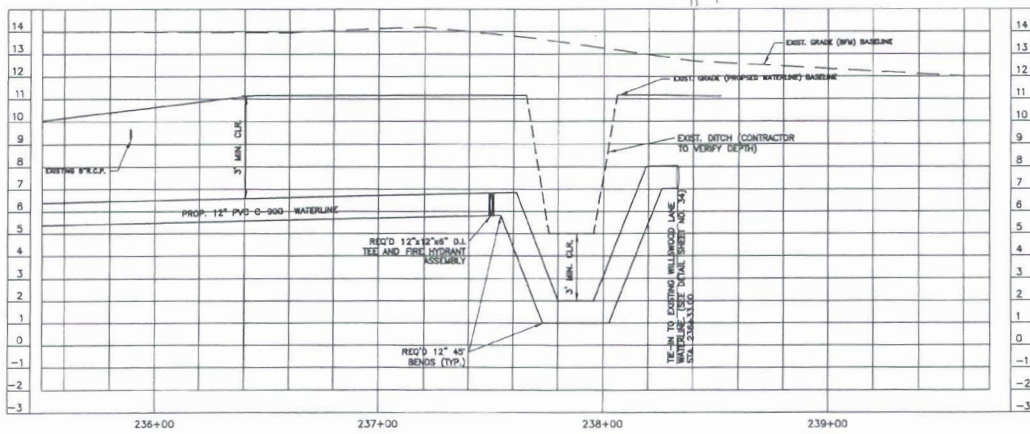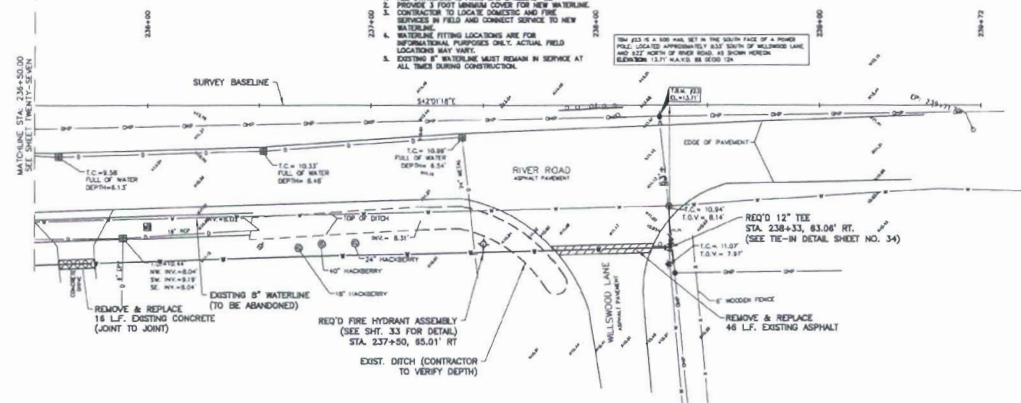


© 1994 by The McGraw-Hill Companies, Inc. All rights reserved. Printed in the United States of America. This book is printed on acid-free paper.

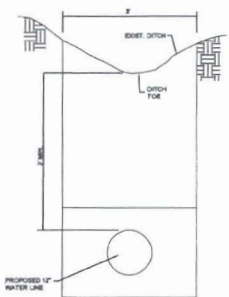

TYPICAL SECTION
TRENCH UNDERNEATH DITCH

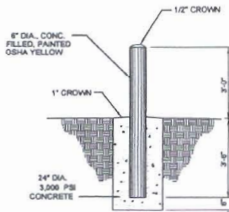


CONCRETE BOLLARD DETAIL
N.T.S.

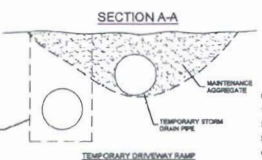


TEMPORARY DRIVEWAY RAMP DETAIL
N.T.S.

- NOTES:
1. CONTRACTOR TO MAINTAIN ACCESS TO ALL DRIVEWAYS UNDER MAINTENANCE AGGREGATE.
 2. TEMPORARY ROAD SHEETING TO BE USED TO MAINTAIN AGGREGATE VERTICAL LIMITS OF DRIVEWAY.
 3. CONTRACTOR TO RESTORE DRIVEWAYS TO ORIGINAL CONDITION.
 4. DRIVEWAYS TO BE MAINTAINED AT ALL TIMES.

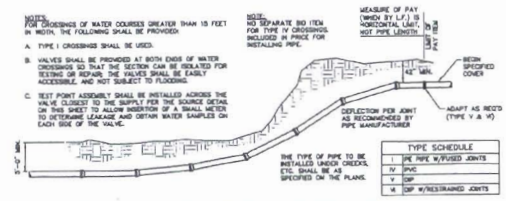

2 TYPICAL CROSSING USING JOINT DEFLECTION

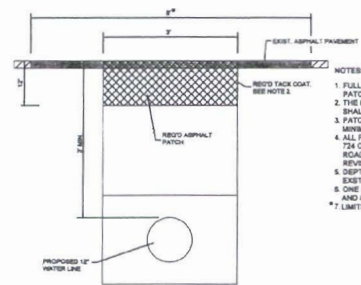

TYPICAL SECTION
TRENCH IN ROADWAY
N.T.S.

- NOTES:
1. FULL DEPTH SAW CUT REQ'D AROUND ENTIRE PATCH PERIMETER.
 2. THE FACE OF EXISTING ASPHALTIC CONCRETE SHALL BE TACK COATED (NO DIRECT PATCH).
 3. PATCHES SHALL NOT BE OVER LAYED FOR A MINIMUM OF FIVE (5) CALENDAR DAYS.
 4. ALL PATCH WORK SHALL CONFORM TO SECTION 724 OF THE LA STANDARD SPECIFICATIONS FOR ROADS & BRIDGES, 2008 ED. AND ITS LATEST REVISIONS.
 5. DEPTH OF ASPHALT PATCH SHALL BE 12" FROM EXISTING ASPHALT GRADE.
 6. ONE (1) FULL LANE OR ROADWAY TO BE MILLED AND OVERLAYED (2" THICK) AFTER PLACEMENT OF PATCH.
 7. LIMITS OF MILL AND OVERLAY NOT REQUIRED AT DRIVEWAYS.

BID PROPOSAL No. 50-00117630
ADDENDUM No.3

digital engineering

LA DEPARTMENT OF HEALTH & HOSPITALS
RIVER ROAD WATER LINE REPLACEMENT
RIVET BOULEVARD TO PARISH LINE
ASPHALT PAVEMENT DETAIL & JAY DETAIL

PROJECT NO. 514-01
DATE OCTOBER 2018
SCALE 3/4"=1'-0"
SHEET NO. 35

LOUISIANA UNIFORM PUBLIC WORK BID FORM

TO: Jefferson Parish Purchasing Department
200 Derbigny Street, Suite 4400
Gretna, Louisiana 70053
ATTN: Purchasing
(Owner to provide name and address of owner)

BID FOR: River Road Waterline Replacement – Phase 2
Willswood Lane to Rivet Blvd.
Public Works Project No. 2015-049-WR
Bid Proposal No. 50-00117630
(Owner to provide name of project and other identifying information)

The undersigned bidder hereby declares and represents that she/he; a) has carefully examined and understands the Bidding Documents, b) has not received, relied on, or based his bid on any verbal instructions contrary to the Bidding Documents or any addenda, c) has personally inspected and is familiar with the project site, and hereby proposes to provide all labor, materials, tools, appliances and facilities as required to perform, in a workmanlike manner, all work and services for the construction and completion of the referenced project, all in strict accordance with the Bidding Documents prepared by: _____

Digital Engineering and dated: 8/01/2016
(Owner to provide name of entity preparing bidding documents.)

Bidders must acknowledge all addenda. The Bidder acknowledges receipt of the following **ADDENDA:** (Enter the number the Designer has assigned to each of the addenda that the Bidder is acknowledging) #1, 9/29/16 #2, 10/03/16 #3, 10/10/16 .

#4, 10/11/16
TOTAL BASE BID: For all work required by the Bidding Documents (including any and all unit prices designated "Base Bid" * but not alternates) the sum of:

_____ Dollars (\$ _____)

ALTERNATES: For any and all work required by the Bidding Documents for Alternates including any and all unit prices designated as alternates in the unit price description.

Alternate No. 1 *(Owner to provide description of alternate and state whether add or deduct)* for the lump sum of:

N/A Dollars (\$ _____)

Alternate No. 2 *(Owner to provide description of alternate and state whether add or deduct)* for the lump sum of:

N/A Dollars (\$ _____)

Alternate No. 3 *(Owner to provide description of alternate and state whether add or deduct)* for the lump sum of:

N/A Dollars (\$ _____)

NAME OF BIDDER: Wallace C. Drennan, Inc.

ADDRESS OF BIDDER: P.O. Box 15438
New Orleans, LA 70175-5438

LOUISIANA CONTRACTOR'S LICENSE NUMBER: # 1033

NAME OF AUTHORIZED SIGNATORY OF BIDDER: Wallace C. Drennan, III

TITLE OF AUTHORIZED SIGNATORY OF BIDDER: President

SIGNATURE OF AUTHORIZED SIGNATORY OF BIDDER **: Wallace C. Drennan

DATE: October 25, 2016

* The Unit Price Form shall be used if the contract includes unit prices. Otherwise it is not required and need not be included with the form. The number of unit prices that may be included is not limited and additional sheets may be included if needed.

** If someone other than a corporate officer signs for the Bidder/Contractor, a copy of a corporate resolution or other signature authorization shall be required for submission of bid. Failure to include a copy of the appropriate signature authorization, if required, may result in the rejection of the bid unless bidder has complied with La. R.S. 38:2212(B)5.

BID SECURITY in the form of a bid bond, certified check or cashier's check as prescribed by LA RS 38:2218.A is attached to and made a part of this bid.

LOUISIANA UNIFORM PUBLIC WORK BID FORM

UNIT PRICE FORM

TO: Jefferson Parish Purchasing Department
 200 Derbigny Street, Suite 4400
 Gretna, Louisiana 70053
 ATTN: Purchasing
 (Owner to provide name and address of owner)

BID FOR: River Road Waterline Replacement – Phase 2
 Williswood Lane to Rivet Blvd.
 Public Works Project No. 2015-049-WR
 Bid Proposal No. 50-00117630
 (Owner to provide name of project and other identifying information)

UNIT PRICES: This form shall be used for any and all work required by the Bidding Documents and described as unit prices. Amounts shall be stated in figures and only in figures.

DESCRIPTION:	REMOVAL OF STRUCTURES AND OBSTRUCTIONS	<input checked="" type="checkbox"/> Base Bid or <input type="checkbox"/> Alt.#	UNIT PRICE	UNIT PRICE EXTENSION (Quantity times Unit Price)
REF. NO.	QUANTITY:	UNIT OF MEASURE:		
202-02-00100	1	Lump Sum	\$45,000.00	\$45,000.00

DESCRIPTION:	REMOVE AND REPLACE CONCRETE BOLLARDS	<input checked="" type="checkbox"/> Base Bid or <input type="checkbox"/> Alt.#	UNIT PRICE	UNIT PRICE EXTENSION (Quantity times Unit Price)
REF. NO.	QUANTITY:	UNIT OF MEASURE:		
S-001	8	Each		

DESCRIPTION:	REMOVAL OF CONCRETE DRIVES	<input checked="" type="checkbox"/> Base Bid or <input type="checkbox"/> Alt.#	UNIT PRICE	UNIT PRICE EXTENSION (Quantity times Unit Price)
REF. NO.	QUANTITY:	UNIT OF MEASURE:		
202-02-06100	900	Sq. Yd.		

DESCRIPTION:	REMOVE AND REPLACE WOODEN BOLLARDS	<input checked="" type="checkbox"/> Base Bid or <input type="checkbox"/> Alt.#	UNIT PRICE	UNIT PRICE EXTENSION (Quantity times Unit Price)
REF. NO.	QUANTITY:	UNIT OF MEASURE:		
S-004	120	Each		

DESCRIPTION:	TEMPORARY EROSION CONTROL	<input checked="" type="checkbox"/> Base Bid or <input type="checkbox"/> Alt.#	UNIT PRICE	UNIT PRICE EXTENSION (Quantity times Unit Price)
REF. NO.	QUANTITY:	UNIT OF MEASURE:		
204-01-10000	1	Lump		

DESCRIPTION:	TRAFFIC MAINTENANCE AGGREGATE		UNIT PRICE	UNIT PRICE EXTENSION (Quantity times Unit Price)
REF. NO.	QUANTITY:	UNIT OF MEASURE:		
402-01-00100	180	Cu Yd.		

DESCRIPTION:	24" RCP NEW DRIVEWAY PIPE	<input checked="" type="checkbox"/> Base Bid or <input type="checkbox"/> Alt.#	UNIT PRICE	UNIT PRICE EXTENSION (Quantity times Unit Price)
REF. NO.	QUANTITY:	UNIT OF MEASURE:		
701-03-00100	4	Each		

All quantities are estimated. The contractor will be paid based upon actual quantities as verified by the Owner

LOUISIANA UNIFORM PUBLIC WORK BID FORM

UNIT PRICE FORM

TO: Jefferson Parish Purchasing Department
200 Derbigny Street, Suite 4400
Gretna, Louisiana 70053
ATTN: Purchasing
(Owner to provide name and address of owner)

BID FOR: River Road Waterline Replacement – Phase 2
Williswood Lane to Rivet Blvd.
Public Works Project No. 2015-049-WR
Bid Proposal No. 50-00117630
(Owner to provide name of project and other identifying information)

UNIT PRICES: This form shall be used for any and all work required by the Bidding Documents and described as unit prices. Amounts shall be stated in figures and only in figures.

DESCRIPTION:	CONCRETE DRIVE (6" THICK) <input type="checkbox"/> Base Bid or <input type="checkbox"/> Alt.#	UNIT PRICE	UNIT PRICE EXTENSION (Quantity times Unit Price)
REF. NO.	QUANTITY:	UNIT OF MEASURE:	
706-02-00200	900	Sq. Yd.	

DESCRIPTION:	SLAB SODDING (ST. AUGUSTINE) <input type="checkbox"/> Base Bid or <input type="checkbox"/> Alt.#	UNIT PRICE	UNIT PRICE EXTENSION (Quantity times Unit Price)
REF. NO.	QUANTITY:	UNIT OF MEASURE:	
714-01-00600	2,600	Sq. Yd.	

DESCRIPTION:	SEEDING <input type="checkbox"/> Base Bid or <input type="checkbox"/> Alt.#	UNIT PRICE	UNIT PRICE EXTENSION (Quantity times Unit Price)
REF. NO.	QUANTITY:	UNIT OF MEASURE:	
717-01-00100	80	Lbs.	

DESCRIPTION:	MOBILIZATION <input type="checkbox"/> Base Bid or <input type="checkbox"/> Alt.#	UNIT PRICE	UNIT PRICE EXTENSION (Quantity times Unit Price)
REF. NO.	QUANTITY:	UNIT OF MEASURE:	
727-01-00100	1	Lump	

DESCRIPTION:	ADJUSTING WATER METER BOX <input type="checkbox"/> Base Bid or <input type="checkbox"/> Alt.#	UNIT PRICE	UNIT PRICE EXTENSION (Quantity times Unit Price)
REF. NO.	QUANTITY:	UNIT OF MEASURE:	
741-11-00200	30	Each	

DESCRIPTION:	MAINTENANCE OF TRAFFIC, SIGNS AND BARRICADES <input type="checkbox"/> Base Bid or <input type="checkbox"/> Alt.#	UNIT PRICE	UNIT PRICE EXTENSION (Quantity times Unit Price)
REF. NO.	QUANTITY:	UNIT OF MEASURE:	
NS-MNT-20032	1	Lump	

DESCRIPTION:	EXPLORATORY EXCAVATION <input type="checkbox"/> Base Bid or <input type="checkbox"/> Alt.#	UNIT PRICE	UNIT PRICE EXTENSION (Quantity times Unit Price)
REF. NO.	QUANTITY:	UNIT OF MEASURE:	
S-002	40	Each	

All quantities are estimated. The contractor will be paid based upon actual quantities as verified by the Owner

LOUISIANA UNIFORM PUBLIC WORK BID FORM

UNIT PRICE FORM

TO: Jefferson Parish Purchasing Department
 200 Derbigny Street, Suite 4400
 Gretna, Louisiana 70053
 ATTN: Purchasing
 (Owner to provide name and address of owner)

BID FOR: River Road Waterline Replacement – Phase 2
 Willswood Lane to Rivet Blvd.
 Public Works Project No. 2015-049-WR
 Bid Proposal No. 50-00117630
 (Owner to provide name of project and other identifying information)

UNIT PRICES: This form shall be used for any and all work required by the Bidding Documents and described as unit prices. Amounts shall be stated in figures and only in figures.

DESCRIPTION:	TEMPORARY DRIVEWAY RAMP <input checked="" type="checkbox"/> Base Bid or <input type="checkbox"/> Alt.#	UNIT PRICE	UNIT PRICE EXTENSION (Quantity times Unit Price)
REF. NO.	QUANTITY: UNIT OF MEASURE:		
S-003	30 Each		

DESCRIPTION:	ASPHALT PATCHING <input checked="" type="checkbox"/> Base Bid or <input type="checkbox"/> Alt.#	UNIT PRICE	UNIT PRICE EXTENSION (Quantity times Unit Price)
REF. NO.	QUANTITY: UNIT OF MEASURE:		
510-01-00100	360 Sq. Yd.		

DESCRIPTION:	GRIND EXISTING STUMPS <input checked="" type="checkbox"/> Base Bid or <input type="checkbox"/> Alt.#	UNIT PRICE	UNIT PRICE EXTENSION (Quantity times Unit Price)
REF. NO.	QUANTITY: UNIT OF MEASURE:		
S-005	2 Each		

DESCRIPTION:	PROJECT SIGN <input checked="" type="checkbox"/> Base Bid or <input type="checkbox"/> Alt.#	UNIT PRICE	UNIT PRICE EXTENSION (Quantity times Unit Price)
REF. NO.	QUANTITY: UNIT OF MEASURE:		
S-006	2 Each		

DESCRIPTION:	REMOVE AND REPLACE GRAVEL DRIVES <input checked="" type="checkbox"/> Base Bid or <input type="checkbox"/> Alt.#	UNIT PRICE	UNIT PRICE EXTENSION (Quantity times Unit Price)
REF. NO.	QUANTITY: UNIT OF MEASURE:		
S-007	325 Sq. Yd.		

DESCRIPTION:	REMOVAL OF FIRE HYDRANTS <input checked="" type="checkbox"/> Base Bid or <input type="checkbox"/> Alt.#	UNIT PRICE	UNIT PRICE EXTENSION (Quantity times Unit Price)
REF. NO.	QUANTITY: UNIT OF MEASURE:		
S-009	11 Each		

DESCRIPTION:	FENCE ANY KIND <input checked="" type="checkbox"/> Base Bid or <input type="checkbox"/> Alt.#	UNIT PRICE	UNIT PRICE EXTENSION (Quantity times Unit Price)
REF. NO.	QUANTITY: UNIT OF MEASURE:		
S-010	500 Lin. Ft.		

DESCRIPTION:	WATER MAIN (6") (PVC C900) <input checked="" type="checkbox"/> Base Bid or <input type="checkbox"/> Alt.#	UNIT PRICE	UNIT PRICE EXTENSION (Quantity times Unit Price)
REF. NO.	QUANTITY: UNIT OF MEASURE:		
W-106	20 Lin. Ft.		

All quantities are estimated. The contractor will be paid based upon actual quantities as verified by the Owner

Revised October 10, 2016 – Addendum No. 3

LOUISIANA UNIFORM PUBLIC WORK BID FORM

UNIT PRICE FORM

TO: Jefferson Parish Purchasing Department
200 Derbigny Street, Suite 4400
Gretna, Louisiana 70053
ATTN: Purchasing
(Owner to provide name and address of owner)

BID FOR: River Road Waterline Replacement – Phase 2
Williswood Lane to Rivet Blvd.
Public Works Project No. 2015-049-WR
Bid Proposal No. 50-00117630
(Owner to provide name of project and other identifying information)

UNIT PRICES: This form shall be used for any and all work required by the Bidding Documents and described as unit prices. Amounts shall be stated in figures and only in figures.

DESCRIPTION:	WATER MAIN (8") (PVC C900) <input checked="" type="checkbox"/> Base Bid or <input type="checkbox"/> Alt.#	UNIT PRICE	UNIT PRICE EXTENSION (Quantity times Unit Price)
REF. NO.	QUANTITY:	UNIT OF MEASURE:	
W-108	200	Lin. Ft.	

DESCRIPTION:	WATER MAIN (12") (PVC C900) <input checked="" type="checkbox"/> Base Bid or <input type="checkbox"/> Alt.#	UNIT PRICE	UNIT PRICE EXTENSION (Quantity times Unit Price)
REF. NO.	QUANTITY:	UNIT OF MEASURE:	
W-112	12,910	Lin. Ft.	

DESCRIPTION:	WATER MAIN (6") (DUCTILE IRON PIPE) <input checked="" type="checkbox"/> Base Bid or <input type="checkbox"/> Alt.#	UNIT PRICE	UNIT PRICE EXTENSION (Quantity times Unit Price)
REF. NO.	QUANTITY:	UNIT OF MEASURE:	
W-206	100	Lin. Ft.	

DESCRIPTION:	WATER MAIN (8") (DUCTILE IRON PIPE) <input checked="" type="checkbox"/> Base Bid or <input type="checkbox"/> Alt.#	UNIT PRICE	UNIT PRICE EXTENSION (Quantity times Unit Price)
REF. NO.	QUANTITY:	UNIT OF MEASURE:	
W-208	100	Lin. Ft.	

DESCRIPTION:	WATER MAIN (12") (DUCTILE IRON PIPE) <input checked="" type="checkbox"/> Base Bid or <input type="checkbox"/> Alt.#	UNIT PRICE	UNIT PRICE EXTENSION (Quantity times Unit Price)
REF. NO.	QUANTITY:	UNIT OF MEASURE:	
W-212	100	Lin. Ft.	

DESCRIPTION:	GATE VALVE AND VALVE BOX (6") <input checked="" type="checkbox"/> Base Bid or <input type="checkbox"/> Alt.#	UNIT PRICE	UNIT PRICE EXTENSION (Quantity times Unit Price)
REF. NO.	QUANTITY:	UNIT OF MEASURE:	
W-406	1	Each	

DESCRIPTION:	GATE VALVE AND VALVE BOX (8") <input checked="" type="checkbox"/> Base Bid or <input type="checkbox"/> Alt.#	UNIT PRICE	UNIT PRICE EXTENSION (Quantity times Unit Price)
REF. NO.	QUANTITY:	UNIT OF MEASURE:	
W-408	12	Each	

DESCRIPTION:	GATE VALVE AND VALVE BOX (12") <input checked="" type="checkbox"/> Base Bid or <input type="checkbox"/> Alt.#	UNIT PRICE	UNIT PRICE EXTENSION (Quantity times Unit Price)
REF. NO.	QUANTITY:	UNIT OF MEASURE:	
W-412	46	Each	

All quantities are estimated. The contractor will be paid based upon actual quantities as verified by the Owner

LOUISIANA UNIFORM PUBLIC WORK BID FORM

UNIT PRICE FORM

TO: Jefferson Parish Purchasing Department
 200 Derbigny Street, Suite 4400
 Gretna, Louisiana 70053
 ATTN: Purchasing
 (Owner to provide name and address of owner)

BID FOR: River Road Waterline Replacement – Phase 2
 Willswood Lane to Rivet Blvd.
 Public Works Project No. 2015-049-WR
 Bid Proposal No. 50-00117630
 (Owner to provide name of project and other identifying information)

UNIT PRICES: This form shall be used for any and all work required by the Bidding Documents and described as unit prices. Amounts shall be stated in figures and only in figures.

DESCRIPTION:	PIPE RESERTAINT (6") <input type="checkbox"/> Base Bid or <input type="checkbox"/> Alt.#	UNIT PRICE	UNIT PRICE EXTENSION (Quantity times Unit Price)
REF. NO.	QUANTITY: UNIT OF MEASURE:		
W-706	2 Each		

DESCRIPTION:	PIPE RESERTAINT (8") <input type="checkbox"/> Base Bid or <input type="checkbox"/> Alt.#	UNIT PRICE	UNIT PRICE EXTENSION (Quantity times Unit Price)
REF. NO.	QUANTITY: UNIT OF MEASURE:		
W-708	22 Each		

DESCRIPTION:	PIPE RESERTAINT (12") <input type="checkbox"/> Base Bid or <input type="checkbox"/> Alt.#	UNIT PRICE	UNIT PRICE EXTENSION (Quantity times Unit Price)
REF. NO.	QUANTITY: UNIT OF MEASURE:		
W-712	100 Each		

DESCRIPTION:	TRANSITIONAL COUPLING (6") <input type="checkbox"/> Base Bid or <input type="checkbox"/> Alt.#	UNIT PRICE	UNIT PRICE EXTENSION (Quantity times Unit Price)
REF. NO.	QUANTITY: UNIT OF MEASURE:		
W-806	1 Each		

DESCRIPTION:	TRANSITIONAL COUPLING (8") <input type="checkbox"/> Base Bid or <input type="checkbox"/> Alt.#	UNIT PRICE	UNIT PRICE EXTENSION (Quantity times Unit Price)
REF. NO.	QUANTITY: UNIT OF MEASURE:		
W-807	13 Each		

DESCRIPTION:	TRANSITIONAL COUPLING (12") <input type="checkbox"/> Base Bid or <input type="checkbox"/> Alt.#	UNIT PRICE	UNIT PRICE EXTENSION (Quantity times Unit Price)
REF. NO.	QUANTITY: UNIT OF MEASURE:		
W-810	3 Each		

DESCRIPTION:	DUCTILE IRON FITTINGS <input type="checkbox"/> Base Bid or <input type="checkbox"/> Alt.#	UNIT PRICE	UNIT PRICE EXTENSION (Quantity times Unit Price)
REF. NO.	QUANTITY: UNIT OF MEASURE:		
W-901	12,000 Lbs.		

DESCRIPTION:	FIRE HYDRANT ASSEMBLY <input type="checkbox"/> Base Bid or <input type="checkbox"/> Alt.#	UNIT PRICE	UNIT PRICE EXTENSION (Quantity times Unit Price)
REF. NO.	QUANTITY: UNIT OF MEASURE:		
W-902-A	27 Each		

All quantities are estimated. The contractor will be paid based upon actual quantities as verified by the Owner

LOUISIANA UNIFORM PUBLIC WORK BID FORM

UNIT PRICE FORM

TO: Jefferson Parish Purchasing Department
 200 Derbigny Street, Suite 4400
 Gretna, Louisiana 70053
 ATTN: Purchasing
 (Owner to provide name and address of owner)

BID FOR: River Road Waterline Replacement – Phase 2
 Williswood Lane to Rivet Blvd.
 Public Works Project No. 2015-049-WR
 Bid Proposal No. 50-00117630
 (Owner to provide name of project and other identifying information)

UNIT PRICES: This form shall be used for any and all work required by the Bidding Documents and described as unit prices. Amounts shall be stated in figures and only in figures.

DESCRIPTION:	WATER SERVICE CONNECTION (<1")	<input checked="" type="checkbox"/> Base Bid or <input type="checkbox"/> Alt.#	UNIT PRICE	UNIT PRICE EXTENSION (Quantity times Unit Price)
REF. NO.	QUANTITY:	UNIT OF MEASURE:		
W-903-0	20	Each		

DESCRIPTION:	WATER SERVICE CONNECTION (1")	<input checked="" type="checkbox"/> Base Bid or <input type="checkbox"/> Alt.#	UNIT PRICE	UNIT PRICE EXTENSION (Quantity times Unit Price)
REF. NO.	QUANTITY:	UNIT OF MEASURE:		
W-903-1	10	Each		

DESCRIPTION:	WATER SERVICE CONNECTION (UP TO 2" POLYETHYLENE)	<input checked="" type="checkbox"/> Base Bid or <input type="checkbox"/> Alt.#	UNIT PRICE	UNIT PRICE EXTENSION (Quantity times Unit Price)
REF. NO.	QUANTITY:	UNIT OF MEASURE:		
W-903-2	10	Each		

DESCRIPTION:	ABANDONMENT OF WATERLINE (8")	<input checked="" type="checkbox"/> Base Bid or <input type="checkbox"/> Alt.#	UNIT PRICE	UNIT PRICE EXTENSION (Quantity times Unit Price)
REF. NO.	QUANTITY:	UNIT OF MEASURE:		
W-908	12,910	Lin. Ft.		

DESCRIPTION:	REMOVAL AND DISPOSAL OF AC WATERLINE (6")	<input checked="" type="checkbox"/> Base Bid or <input type="checkbox"/> Alt.#	UNIT PRICE	UNIT PRICE EXTENSION (Quantity times Unit Price)
REF. NO.	QUANTITY:	UNIT OF MEASURE:		
W-907-6	200	Lin. Ft.		

DESCRIPTION:	REMOVAL AND DISPOSAL OF AC WATERLINE (8")	<input checked="" type="checkbox"/> Base Bid or <input type="checkbox"/> Alt.#	UNIT PRICE	UNIT PRICE EXTENSION (Quantity times Unit Price)
REF. NO.	QUANTITY:	UNIT OF MEASURE:		
W-907-8	200	Lin. Ft.		

DESCRIPTION:	HANDICAPPED CURB RAMP	<input checked="" type="checkbox"/> Base Bid or <input type="checkbox"/> Alt.#	UNIT PRICE	UNIT PRICE EXTENSION (Quantity times Unit Price)
REF. NO.	QUANTITY:	UNIT OF MEASURE:		
706-04-00100	4	Each		

DESCRIPTION:	18" RCP NEW DRIVEWAY PIPE	<input checked="" type="checkbox"/> Base Bid or <input type="checkbox"/> Alt.#	UNIT PRICE	UNIT PRICE EXTENSION (Quantity times Unit Price)
REF. NO.	QUANTITY:	UNIT OF MEASURE:		
701-03-00101	2	Each		

All quantities are estimated. The contractor will be paid based upon actual quantities as verified by the Owner

LOUISIANA UNIFORM PUBLIC WORK BID FORM

UNIT PRICE FORM

TO: Jefferson Parish Purchasing Department
200 Derbigny Street, Suite 4400
Gretna, Louisiana 70053
ATTN: Purchasing
(Owner to provide name and address of owner)

BID FOR: River Road Waterline Replacement – Phase 2
Williswood Lane to Rivet Blvd.
Public Works Project No. 2015-049-WR
Bid Proposal No. 50-00117630
(Owner to provide name of project and other identifying information)

UNIT PRICES: This form shall be used for any and all work required by the Bidding Documents and described as unit prices. Amounts shall be stated in figures and only in figures.

DESCRIPTION:	REMOVAL OF PORTLAND CEMENT CONCRETE PAVEMENT	<input checked="" type="checkbox"/> Base Bid or <input type="checkbox"/> Alt.#	UNIT PRICE	UNIT PRICE EXTENSION (Quantity times Unit Price)
REF. NO.	QUANTITY:	UNIT OF MEASURE:		
202-02-02021	700	Sq. Yd.		

DESCRIPTION:	REMOVE CONCRETE WALK	<input checked="" type="checkbox"/> Base Bid or <input type="checkbox"/> Alt.#	UNIT PRICE	UNIT PRICE EXTENSION (Quantity times Unit Price)
REF. NO.	QUANTITY:	UNIT OF MEASURE:		
202-02-06200	150	Sq. Yd.		

DESCRIPTION:	PORTLAND CEMENT CONCRETE (9" THICK)	<input checked="" type="checkbox"/> Base Bid or <input type="checkbox"/> Alt.#	UNIT PRICE	UNIT PRICE EXTENSION (Quantity times Unit Price)
REF. NO.	QUANTITY:	UNIT OF MEASURE:		
601-01-00300	700	Sq. Yd.		

DESCRIPTION:	CONCRETE WALK (4" THICK)	<input checked="" type="checkbox"/> Base Bid or <input type="checkbox"/> Alt.#	UNIT PRICE	UNIT PRICE EXTENSION (Quantity times Unit Price)
REF. NO.	QUANTITY:	UNIT OF MEASURE:		
706-01-00100	150	Sq. Yd.		

DESCRIPTION:	REMOVE AND REPLACE CONCRETE CURB	<input checked="" type="checkbox"/> Base Bid or <input type="checkbox"/> Alt.#	UNIT PRICE	UNIT PRICE EXTENSION (Quantity times Unit Price)
REF. NO.	QUANTITY:	UNIT OF MEASURE:		
707-01-00100	500	Lin. Ft.		

DESCRIPTION:	SUPERPAVE ASPHALTIC PAVEMENT	<input checked="" type="checkbox"/> Base Bid or <input type="checkbox"/> Alt.#	UNIT PRICE	UNIT PRICE EXTENSION (Quantity times Unit Price)
REF. NO.	QUANTITY:	UNIT OF MEASURE:		
502-01-00100	26	Ton		

DESCRIPTION:	COLD PLANING ASPHALTIC CONCRETE PAVEMENT (2" THICK)	<input checked="" type="checkbox"/> Base Bid or <input type="checkbox"/> Alt.#	UNIT PRICE	UNIT PRICE EXTENSION (Quantity times Unit Price)
REF. NO.	QUANTITY:	UNIT OF MEASURE:		
509-01-00100	235	Sq. Yd.		

All quantities are estimated. The contractor will be paid based upon actual quantities as verified by the Owner

Bid Proposal No. 50-00117630
Addendum No. 3

West Jefferson Levee District

7001 River Road
Marrero, LA 70072

Date: 10/4/2016

Permit No.: 1003

This is to certify that Jefferson Parish
 1221 ELMWOOD PARK BLVD
 HARAHAH, LA 70123

is granted a permit to replace 13,100 linear feet of a water line from Willswood Lane to Rivet Boulevard landward of the right descending Mississippi River levee, between second order levee stations 120+00 and 257+00, at Westwego, Louisiana, in Jefferson Parish.

This permit is issued provided the following requirements are complied with:

- 1 All work is to be performed in accordance with the rules and regulations of the Office of Coastal Protection and Restoration and the U.S. Army Corps of Engineers (see Letters of No Objection from Office of Coastal Protection and Restoration and U.S. Army Corps of Engineers, attached).
- 2 The work is accomplished in accordance with applicant's letter dated 5/11/2016 and accompanying typical drawings.
- 3 Construction must begin within 6 months after request is approved, or a request submitted to this Board for an extension of time. Applicant must notify this office when construction work will begin. Before the start of any work covered under this permit, notice shall be given to the Levee District 72 hours in advance by contacting the Permits Group at (504) 371- 6863 or Permit@slfpaw.org
- 4 Applicant and his surety assumes all cost of proper maintenance and upkeep relative to the facility herein permitted.
- 5 That should changes in the location or section of the existing levee and/or river, or in the generally prevailing conditions in the vicinity be required in the future in the public interest, the applicant shall make such changes in the project.
- 6 The applicant agrees to indemnify and save grantor harmless from any and all liability, including liability of grantor to applicant, its heirs, successors, and/or assigns, arising out of and/or incident to the rights herein granted. Applicant further agrees to appear and defend any and all suits instituted against this Board arising out of and/or incident to this permit, and to pay in full any judgment rendered against this Board arising out of and/or incident to the granting of this permit.
- 7 This permit is valid for a period of one year. A request for renewal should be submitted to this office prior to expiration.
- 8 In addition, it is required that a copy of the permit be kept on site.
- 9 Applicant is advised that any damage to the levee as a result of applicant's activities shall be repaired at applicant's expense and to the satisfaction of the Levee District.

Bid Proposal No. 50-00117630
Addendum No. 3

Jefferson Parish
Permit No. 1003
10/4/2016
Page 2

- ¹⁰ That no sub-surface excavations or penetrations greater than 18 inches are performed when the Mississippi River attains or exceeds +11.0 feet NAVD 88 on the Carrollton Gage at New Orleans, without prior documented approval to the contrary from the Department of the US Army Corps of Engineers, New Orleans District.

John R. Monzon, P.E. - Regional Director
Southeast Louisiana Flood Protection Authority - West

ON BEHALF OF THE PERMIT APPLICANT, THE UNDERSIGNED
AGREES TO COMPLY WITH ALL PERMIT STIPULATIONS.

(DATE)

Bid Proposal No. 50-00117630
Addendum No. 3



DEPARTMENT OF THE ARMY
CORPS OF ENGINEERS, NEW ORLEANS DISTRICT
P. O. BOX 60267
NEW ORLEANS, LA 70160-0267

September 15, 2016

REPLY TO
ATTENTION OF

Operations Division
Operations Manager
Completed Works

Mr. John Monzon P.E., M.ASCE - Regional Director
Southeast Louisiana Flood Protection Authority - West
West Jefferson Levee District
7001 River Road
Marrero, Louisiana 70072

Dear Mr. Monzon:

We have received a letter request, dated May 11, 2016, from Digital Engineering, Inc., on behalf of Jefferson Parish Department of Water, concerning permission to replace 13,100 linear feet of a water line from Willswood Lane to Rivet Boulevard landward of the right descending Mississippi River levee, between second order levee stations 120+00 and 257+00, at Westwego, Louisiana, in Jefferson Parish.

We have no objection to your Office's issuance of a permit for the proposed work provided:

a. The work is accomplished in accordance with the above referenced letter and accompanying drawings.

b. All drilling work is performed and completed while the stage of the Mississippi River is below elevation +11.0 feet on the Carrollton gage, at New Orleans, Louisiana. Information concerning current river stages may be obtained on our website at www.mvn.usace.army.mil.

c. Drilling fluid is not allowed in the directional drilling process.

d. All excavation work is performed and backfilled while the stage of the Mississippi River is below elevation +11.0 feet on the Carrollton gage, at New Orleans, Louisiana.

e. All open excavations need to be backfilled to natural ground prior to the river stage rising to +11.0 feet on the Carrollton gage, at New Orleans, Louisiana.

Bid Proposal No. 50-00117630
Addendum No. 3

-2-

d. The applicant must provide written notification to this office of the construction timeline to include the proposed start and end dates. Additionally, the applicant must notify this office prior to commencement and upon completion of the work permitted herein.

This letter of no objection is based upon engineering criteria, and no interpretation or comments regarding local laws, zoning, or ordinances concerning property rights, etc., have been made. Additionally, this letter of no objection does not obviate the applicant's requirement to obtain federal, state, or local permits required by law, and no work should commence until all necessary permits are required.

If you have any questions, please contact me or Mayra Flores of my office at 504-862-2241 or 504-862-2459, respectively. Additionally, future correspondence concerning this project should reference our Letter of No Objection number 16-503. This will allow us to more easily locate records of previous correspondence, and thus provide a quicker response.

Please furnish this office a copy of your permit if the applicant's proposal is approved by your Office.

Sincerely,



Amy E. Powell
Operations Manager, Completed Works

cc:

CPRA
Digital Engineering
Attn: Robert J. Delaune



Coastal Protection and
Restoration Authority of Louisiana

State of Louisiana

July 11, 2016

John Bel Edwards
GOVERNOR

West Jefferson Levee District
7001 River Road
Marrero, LA 70072
Attention: Mr. John Monzon

PERMIT REQUEST FORM OF NO OBJECTION

This Letter of No Objection is not a regulatory permit and does not authorize the implementation of any project without documented approval from all appropriate regulatory authorities.

Permit Applicant: Jefferson Parish Department of Water

Date of Request 06-01-2016
Agent: Digital Engineering

Applicant's Request: Approval to abandon an existing eight-inch diameter water line and replace it with approximately 13,000-linear feet of new 12-inch diameter pipe, fire hydrants, and isolation valves. The pipe will be installed using open-cut and directional drill methods, with the expected diameter of the drill hole to be 25.3-inches. The trench excavation will be three-feet wide by a maximum of nine-feet beneath ground surface, while the average trench depth will be five-feet beneath ground surface. The closest work location is approximately 50-feet from the toe of the Mississippi River Levee.

Received 6/1/16 via e-mail
Project No. 2015-049-WR

Project Location: All work will take place on the protected side of the right-descending Mississippi River Levee, Waggaman, Jefferson Parish, Louisiana.

Project Coordinates:..... 29° 57' 42.840" , -90° 14' 38.630"

The above referenced request has been examined by Coastal Protection and Restoration Authority, and no objection is proffered for this request, provided:

1. This Letter of No Objection is only for stated work within or in the vicinity of the Levee District right-of-way, and must be accomplished in accordance with the details set forth in the applicant's request and the conditions contained herein. Any changes to the limits or scope of the proposed work must be submitted for additional review. The Levee District must be contacted in writing prior to commencement and at the end of activities. The applicant is responsible for obtaining and providing copies of any permits or lease agreements necessary from the U.S. Army Corps of Engineers, the U.S. Coast Guard, the Louisiana State Land Office, the Louisiana Department of Transportation and Development, the Louisiana Department of Natural Resources - Office of Coastal Management, the Louisiana Department of Wildlife and Fisheries, the Parish Government and/or any other applicable agencies, as well as documented approval from the area landowner(s) prior to the initiation of the work. The applicant is responsible for adhering to the provisions of any existing permits. The proposed work must not restrict the Levee District's maintenance operations, or any potential flood fight activities at the levee, nor shall it obstruct or impede drainage, or create areas of standing water on the levee batture. The applicant must employ and maintain suitable erosion protection measures at the project site to the satisfaction of the Levee District. The applicant or owner must immediately notify the Levee District of any seepage or sand boils that occur during high water conditions. All materials associated with the proposed work must be removed from the area upon completion of the project and the area must be returned to its original state of existence or better. Any damage done to the levee, floodwall or other flood

Bid Proposal No. 50-00117630
Addendum No. 3

2016-07-11
Page 2

control structure, revetment, or surrounding project area, resulting from the proposed work must be repaired or replaced by the applicant. Should any change in the location of the existing levee, river, floodwall, drainage canal, waterway, or generally prevailing conditions in the vicinity, or should any changes in the area be required in the future, in the public interest, the applicant shall make such changes in the project as necessary. Any required changes or repairs shall be at the applicant expense. This letter of no objection is offered with no opinion or approval of the design or engineering feasibility of the work.

Failure to abide by the conditions and requirements set forth in this Letter of No Objection may constitute non-compliance with the State of Louisiana comprehensive master coastal protection plan and may subject the levee district and/or the applicant/agent to any and all procedures and actions by CPRA or the CPRA Board pursuant to La. R.S. 49:214.5.2(A)(6) and as may be necessary to ensure compliance with such comprehensive master coastal protection plan.

2. That the proposed activities occur and are completed prior to or after high water stages or hurricane conditions such that no operations are conducted at saturated levee systems. Authorization for work periods will be determined at the discretion of the Levee District.
3. That all subsurface work is performed and backfilled prior to the Mississippi River attaining or exceeding + 11.0 feet NGVD, on the Carrollton Gage at New Orleans, unless the applicant receives documented approval to the contrary from the U.S. Army Corps of Engineers-New Orleans District.
4. That the cutting of trees be kept to the minimum deemed necessary to accomplish the proposed project.
5. That no equipment, vehicles, or materials of any kind are parked or stored on the levee or on its slopes without prior approval from the levee district.
6. That all directional drilling activities must be coordinated and performed with the approval and monitoring of the U.S. Army Corps of Engineers.
7. That if an existing pipeline is being replaced, and will not serve any future use, it must be immediately removed or properly abandoned. Any voids resulting from abandonment of the pipeline section in the area located within 40 feet of the floodside levee toe, and 15 feet of the protected side levee toe, must be completely sealed with cement-bentonite slurry in accordance with the slurry description specified in the State of Louisiana's "Water Well Rules, Regulations and Standards" (November 1985) in Chapter 2, Section 2.6.1.0, Item A.
8. That once directional drilling operations are complete, the ground surface of the work site is returned to pre-project condition and the applicant repairs any damage that may have occurred to existing infrastructure.
9. That the applicant contact the Department of Transportation & Development Office and obtain any permits that may be required for any operations, work or construction occurring within or adjacent to U.S. or Louisiana Highway Right-of-Way. The applicant must adhere to any DOTD District Office requirements imposed for vehicle ramp intersection with the Louisiana Highway right-of-way, as well as for traffic control and safety needs. The appropriate Highway Right-of-Way Permit Contact can be found at the following link:

http://wwwsp.dotd.la.gov/Inside_LaDOTD/Divisions/Engineering/Road_Design/Right-of-Way/Pages/Contacts.aspx
10. That the applicant is responsible for maintaining the existing level of flood protection at all times to the satisfaction of the Levee District.

Bid Proposal No. 50-00117630
Addendum No. 3

2016-07-11
Page 3

11. This Letter of No Objection (LNO) is conditioned upon the applicant/agent providing the following to CPRA, USACE, and the levee district, before commencing any activity allowed under the LNO. Final work products deemed necessary for granting of this Letter of No Objection associated with this project shall be stamped (construction ready drawings, designs, reports, as-builts differing significantly from final plans, etc...) by each professional engineer responsible for their relevant field of practice for the project. Failure to provide information requested or failure to abide by the conditions and requirements contained herein shall constitute grounds for rescinding this Letter of No Objection. In such an event, CPRA will provide notice to USACE and the levee district that the LNO has been rescinded.

Yours very truly,



for Ignacio Harrouch, Operations Division Chief
Coastal Protection and Restoration Authority of Louisiana

15245/bw/rd/jr

cc:

U.S. Army Corps Of Engineers-Levees
Office Of Coastal Management
Mr. Billy Wall

SECTION 02060

ASPHALTIC CONCRETE

1.01 DESCRIPTION

This section of the specifications includes the furnishing of all labor, materials, equipment, and the performance of all asphalt work required for the construction of the roadway in accordance with plan details and Sections 501, 503, 504, 505, 1002 and 1003 of the Louisiana Standard Specifications for Roads and Bridges, 2006 Edition and its latest revisions.

1.02 MATERIALS

Asphalt concrete mixes shall be Superpave wearing course Level 1 (PG70-22m). All materials shall conform to the requirements of Sections 502, 504, 505, 1002, and 1003 of the Louisiana Standard Specifications for Roads and Bridges, 2006 Edition and its latest revisions.

1.03 GENERAL

Asphalt shall be batched and placed in accordance with the requirements of Section 503 referenced above. The mix formula shall be submitted to the Testing Laboratory for prior approval. Recycled material will be allowed per latest Louisiana Standard Specifications for Roads and Bridges, 2006 Edition and its latest revisions.

Asphalt courses shall be laid down to grades shown on the plans and cross-sections after application of prime coat to the compacted base course. Abutting edges of existing asphalt pavement shall be tack-coated.

The testing for surface tolerance shall be in accordance with Section 501 of the Louisiana Standard Specifications for Roads and Bridges, 2006 Edition and its latest revisions.

The Engineer reserves the right to require removal and replacement of deficient areas.

1.04 MEASUREMENT AND PAYMENT

No measurement or direct payment will be made for prime coat or tack coat, but shall be included in the contract price bid for related items.

Penalty and corrective measures for variances from thickness tolerances and width tolerances will be applied as per Section 501.11 and payment adjustment for deficiencies of asphaltic mix will be applied as per Table 501-5 of Section 501 of the Louisiana Standard Specifications for Roads and Bridges, 2006 Edition and its latest revisions.

Payment will be made under:

ITEM 502-01-00100, "SUPERPAVE ASPHALTIC PAVEMENT", per Ton.

END OF SECTION

SECTION 02070

ASPHALTIC CONCRETE PAVEMENT PATCHING

1.01 DESCRIPTION

This work consists of patching existing asphaltic concrete pavement in accordance with these specifications and in conformity with the lines and typical sections shown on the plans or as directed by the Engineer.

All work shall be performed in accordance with the provisions of Section 510 of the Louisiana Standard Specifications for Roads and Bridges, 2006 Edition (Blue Book), and latest revisions, or as amended herein.

1.02 MATERIALS

Asphaltic concrete used for pavement patching shall be Superpave Base Course Level 1 (PG64-22m) in accordance with Section 501.02 of the "Blue Book".

1.03 MEASUREMENT AND PAYMENT

Measurement for asphalt patching will be made by the square yard. Payment shall include asphalt roadway removal, asphaltic concrete pavement patching (12" thick), subgrade material, saw-cutting pavement, subgrade preparation and other require work as per details and specifications shown in the bid documents.

Payment will include all material, equipment, and labor necessary to perform the work and will be made at the contract unit price bid for the pay items shown below:

ITEM 510-01-00100, "ASPHALT PATCHING", per Square Yard

END OF SECTION



CENTRALBIDDING
FROM CENTRAL AUCTION HOUSE

Willow
13

5000117630 RIVER ROAD WATER LINE REPLACEMENT PHASE 2
Jefferson Parish Government

Project documents obtained from www.CentralBidding.com

17-Oct-2016 08:02:08 AM

CONTRACT DOCUMENTS, SPECIFICATIONS
AND
CONTRACT DRAWINGS

FOR

JEFFERSON PARISH
DEPARTMENT OF WATER

RIVER RD. WATERLINE REPLACEMENT
RIVET BLVD. TO WILLSWOOD LANE

PROJECT NO. 2015-049-WR
PROPOSAL NO. 50-00117630

ADDENDUM NO. 4

DATE ISSUED: October 11, 2016

BID DATE: October 25, 2016 at 2:00 PM
(Extended from October 13, 2016)

BID LOCATION: Jefferson Parish General Government Building
Jefferson Parish Purchasing Dept., Suite 4400
200 Derbigny St., Gretna, LA 70053

This addendum shall be part of the Contract Documents as provided in the Instructions to Bidders.

The following items are issued to add to, modify, and clarify the Contract Documents. These items shall have full force and effect as the Contract Documents, and the cost involved shall be included in the bid prices.

Acknowledge receipt of the addendum by inserting its number and date on the Bid Form of the Bid Documents. Failure to do so will result in bid rejection.

This Addendum No. 4 consists of 2 pages including the title sheet and all attachments.

General

The sentence "Failure to do so may subject the bidder to disqualifications." on the Addendum title sheet was changed to "Failure to do so will result in bid rejection."

END OF ADDENDUM